


T. 28S., R. 4W., W. M.

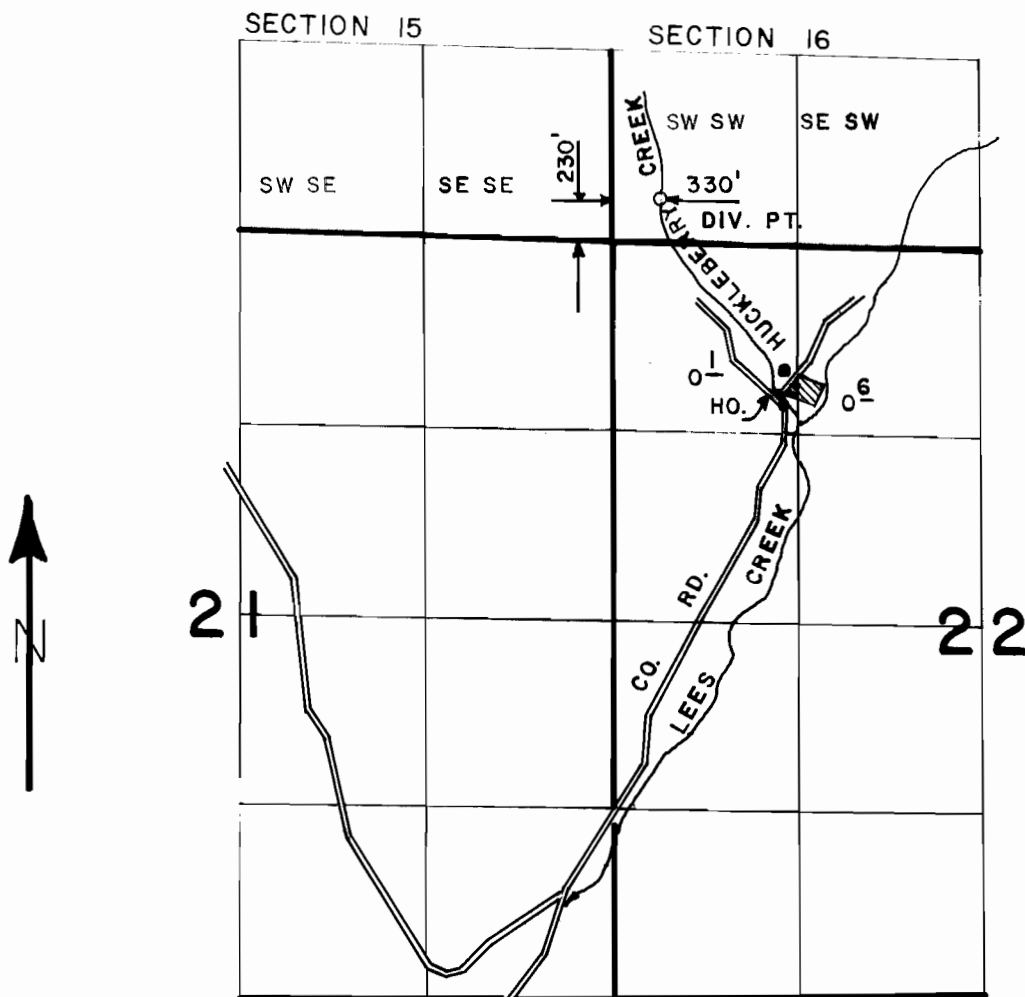

SCALE: 4" = 1 MILE

FINAL PROOF SURVEY
UNDER

Application No. 63460... Permit No. 46815.....
IN NAME OF

WILLIAM L. RICE

Surveyed AUG. 3... 1988, by J.M. SCHMORDE