


T. 38 S., R. 4 W., W. M.

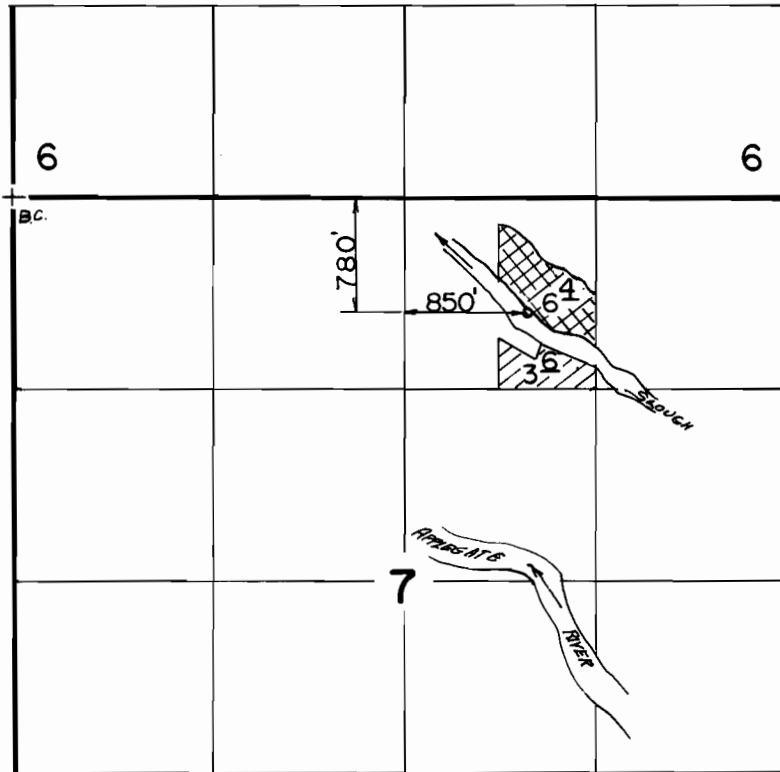

Scale: 1" = 1320'

supplemental



FINAL PROOF SURVEY
UNDER

Application No. 63554 Permit No. 46852
IN NAME OF

JAMES S. B. LINDA SHEA FORD

Surveyed FEB. 9. 1988, by B. S. JAMES