


T. 31 S., R. 38 & 4 W., W. M.

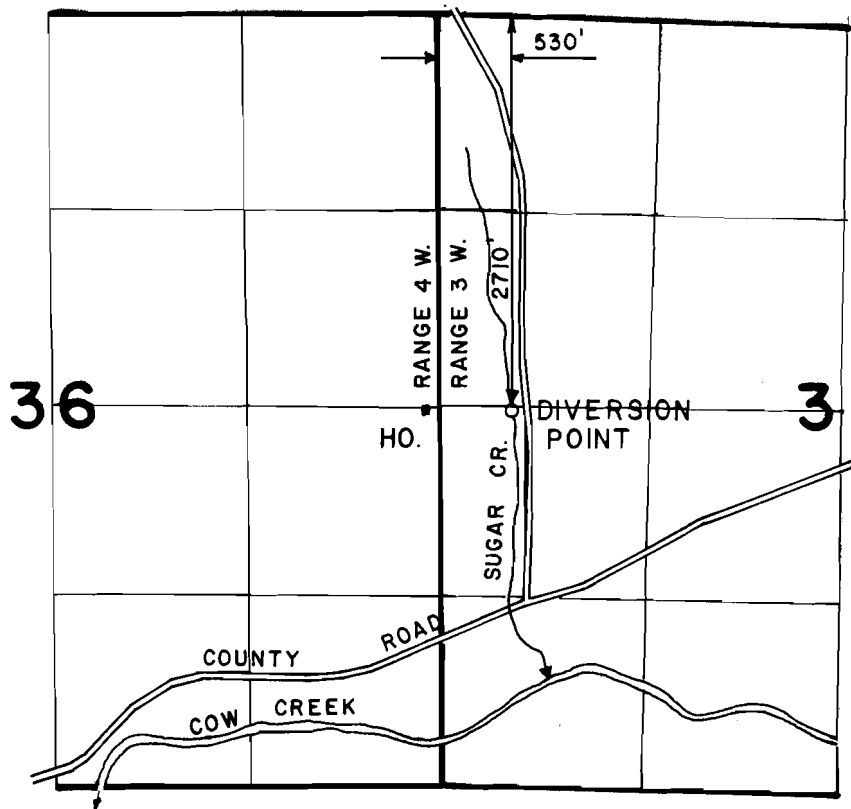

SCALE: 4" = 1 MILE

FINAL PROOF SURVEY
UNDER

Application No. 63630... Permit No. 46871...
IN NAME OF

MICHAEL SHARKEY

Surveyed JULY 6... 1988, by J. M. SCHMORDE.