


T. 38 S., R. 5 W., W. M.

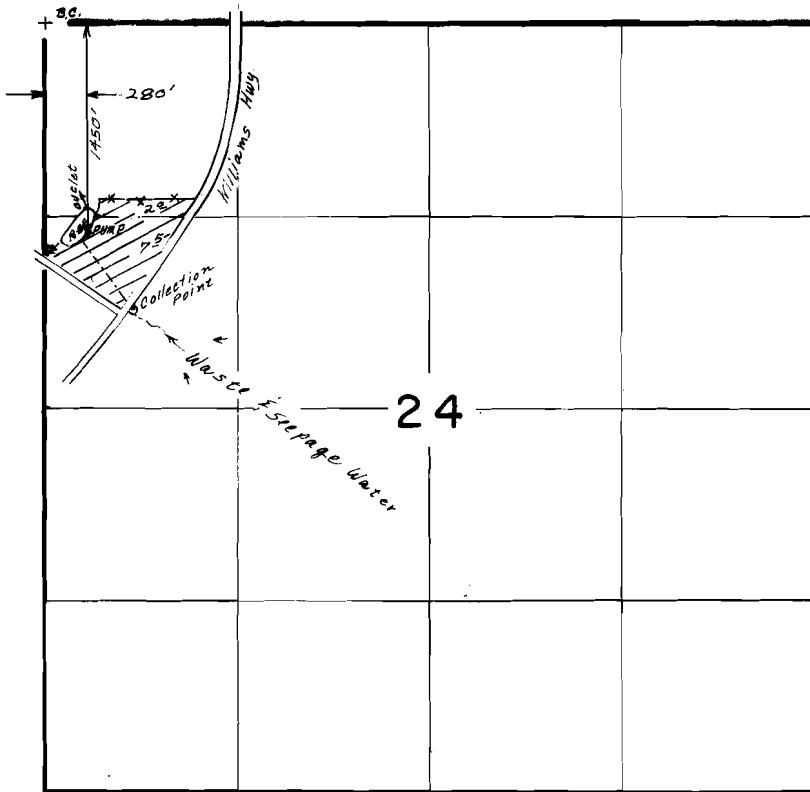

Scale: 1" = 1320'

**FINAL PROOF SURVEY**  
UNDER

R-65266      R-8837  
Application No. 64167      Permit No. 47765

IN NAME OF

JAMES C. & EDITH L. KEDING

Surveyed AUG...8... 19.88, by B...S...JAMES....