


T. 38 S., R. 5 W., W. M.

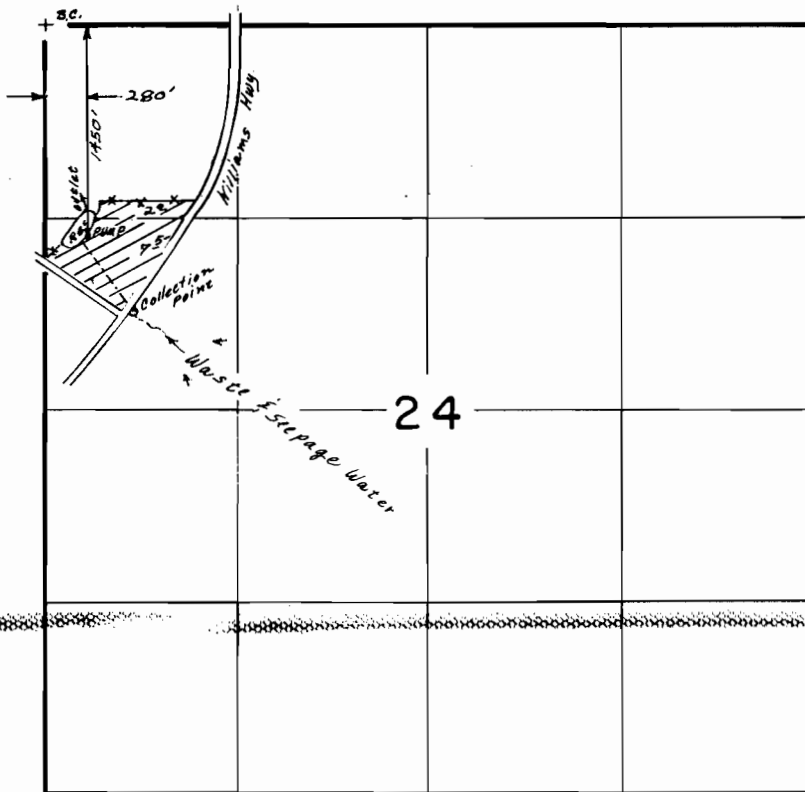

Scale: 1" = 1320'

FINAL PROOF SURVEY

UNDER

Application No. R-65266 64167 Permit No. R-8837 47765

IN NAME OF

JAMES C. & EDITH L. KEDING

Surveyed AUG. 8. 19.88, by B. S. JAMES.