


T. 28 S., R. 13 W., W.M.

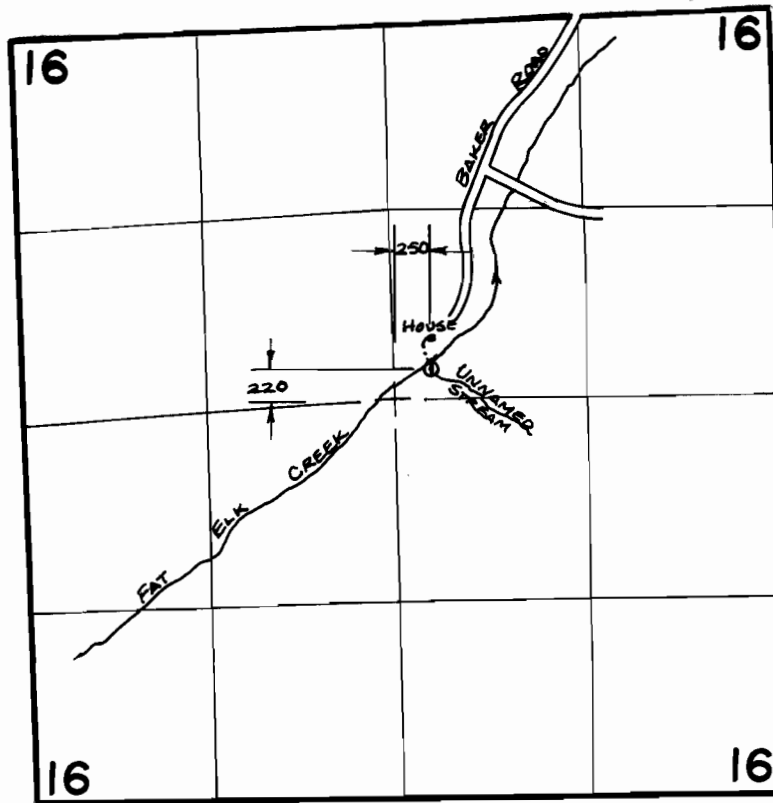

SCALE : 4" = 1 MILE

FINAL PROOF SURVEY UNDER

Application No. ...65035. Permit No. ...47785....
IN NAME OF

...JEAN R. & LEONA M. UNRUH...

Surveyed3/16..... 19.88, byM. SCHMORDE...