


T. 39 S., R. 8 W., W. M.

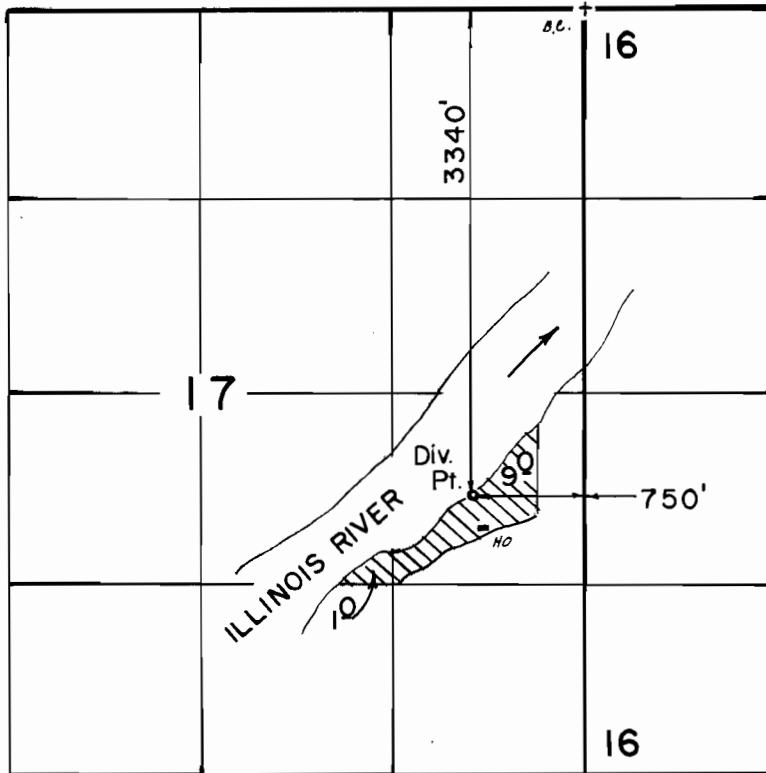

Scale: 1" = 1320'

**FINAL PROOF SURVEY**  
UNDER

Application No. ~~65138~~ Permit No. ~~47580~~  
IN NAME OF

.....**C. N. VERSTEEG**.....

Surveyed **MAY 17, 1988**, by **B. S. JAMES**....