


T. 3 N., R. 1 & 2 W., W.M.

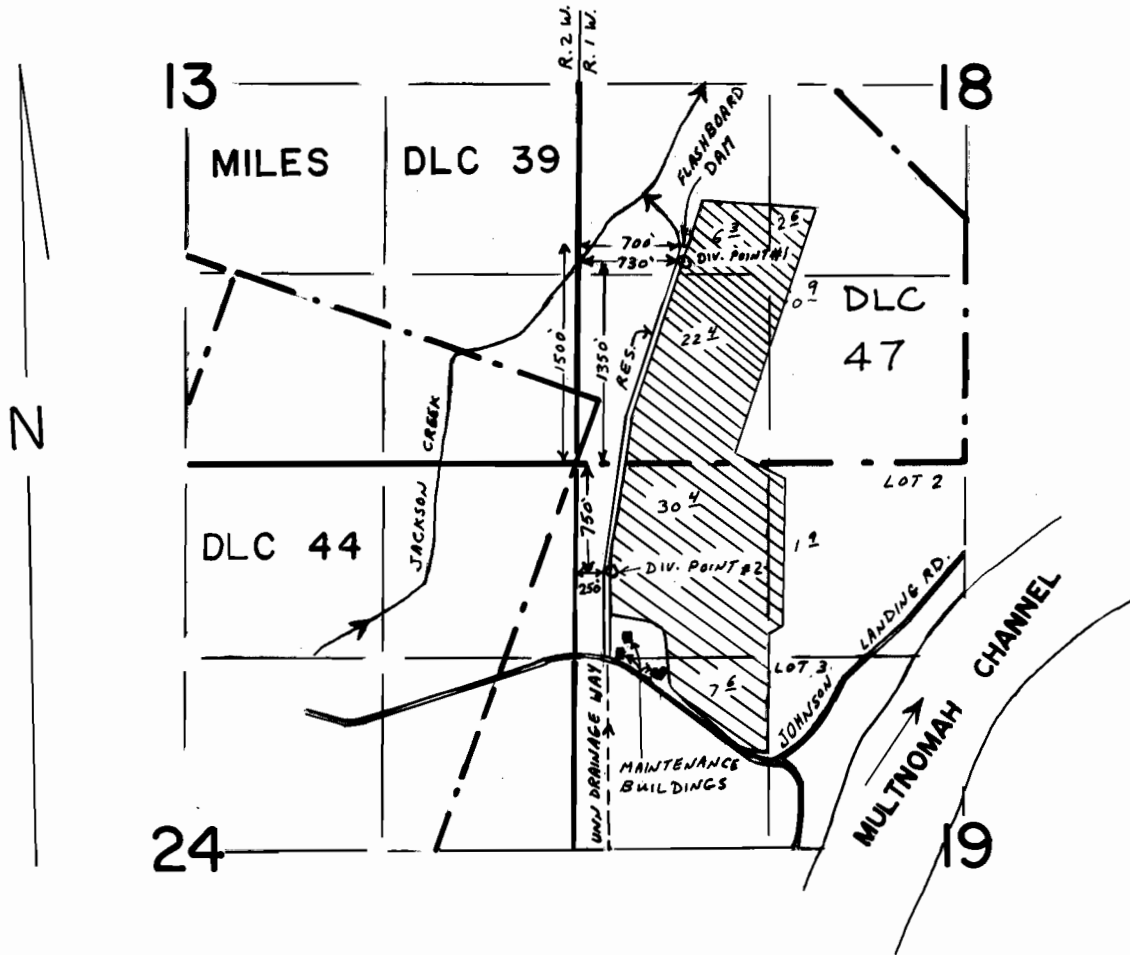

SCALE 1" = 1320'

FINAL PROOF SURVEY

UNDER

R-67891

R-9394

Application No. **67890** Permit No. **48265**
IN NAME OF

JAMES T. ERNEST

Surveyed **SEP 6 1988** by **Z. SALEH**