


T. 3 N., R. 1 & 2 W., W.M.

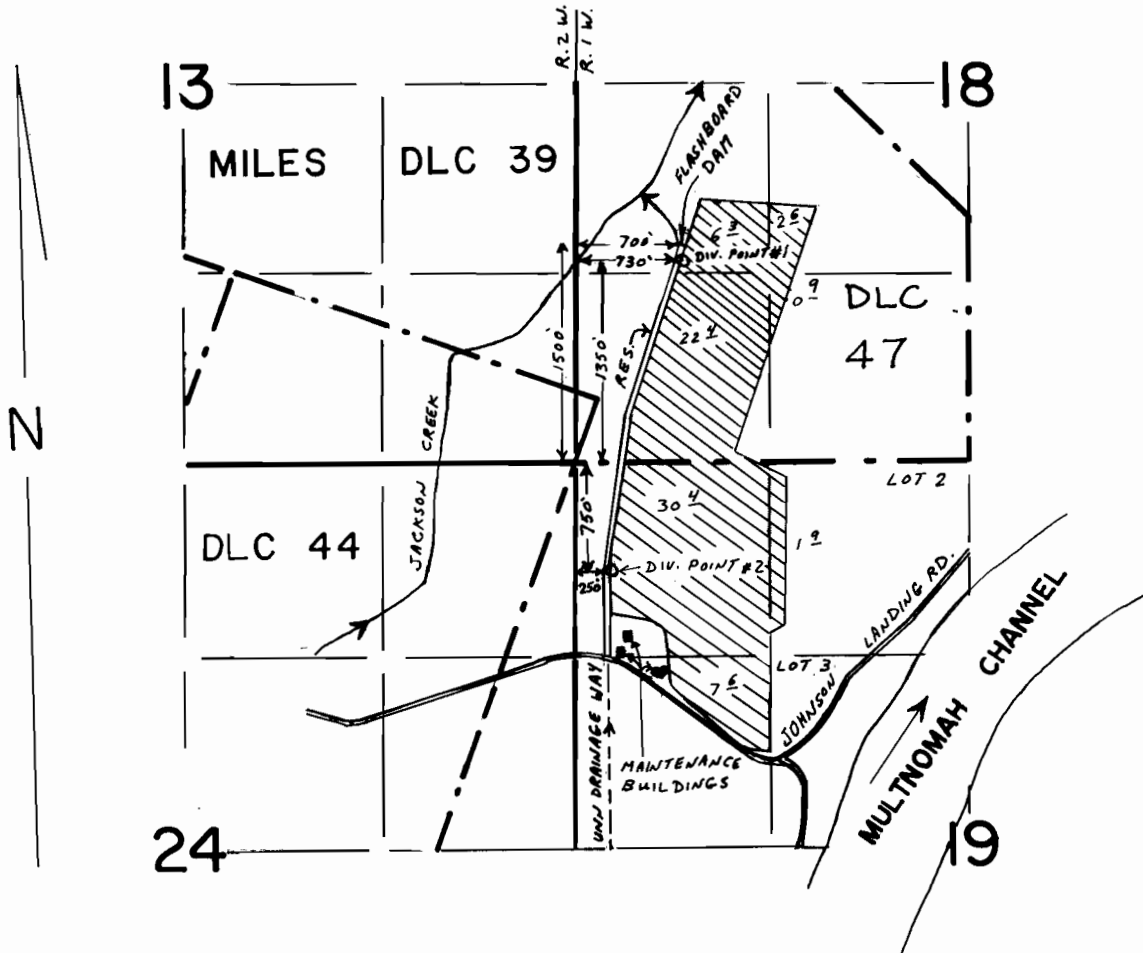

SCALE 1" = 1320'

FINAL PROOF SURVEY

UNDER

R-67891

R-9394

Application No. 67890 Permit No. 48265

IN NAME OF

JAMES T. ERNEST

Surveyed SEP 6 19 88 by Z. SALEH