
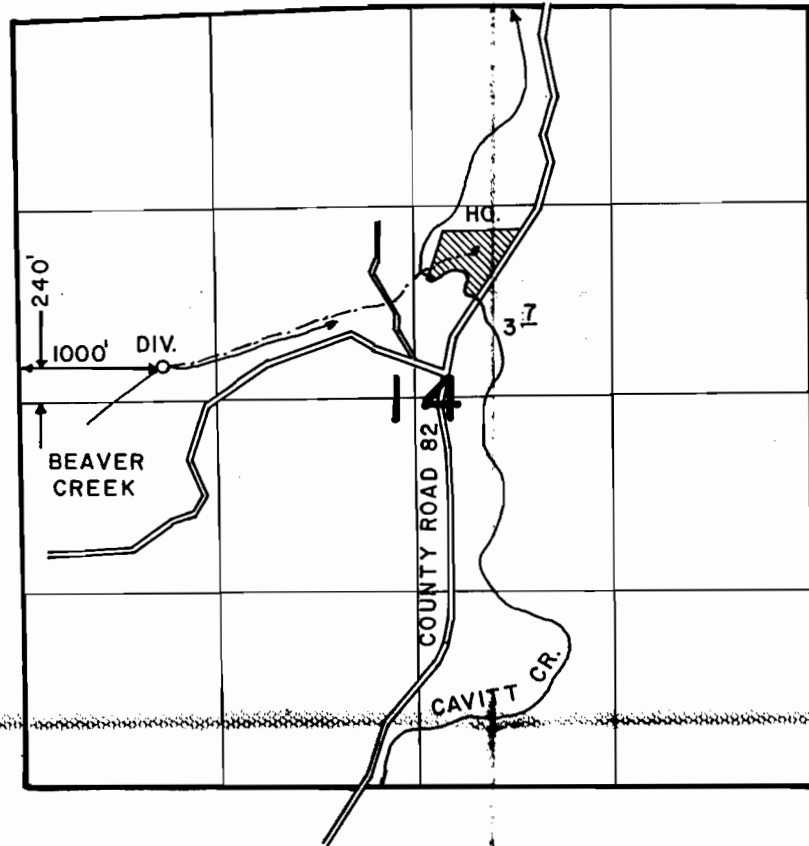


T. 27 S., R. 3 W., W. M.

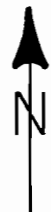

SCALE: 4" = 1 MILE

**FINAL PROOF SURVEY**  
UNDER

Application No. 68207 48973  
64773 Permit No. 47348  
IN NAME OF

.....RONALD K. BALDWIN.....

Surveyed APR. 5..... 1988., by J. M. SCHMORDE.