

James Pierce DLC no. 40
SW1/4 NE1/4 S12, T15S, R3W, WM

1/4
cor.

1 6

12 7




1"=400'

This survey is for water resources use only
and does not provide information relative to
the locations of property boundaries.

NW 1/4 NE 1/4

NE 1/4 NE 1/4

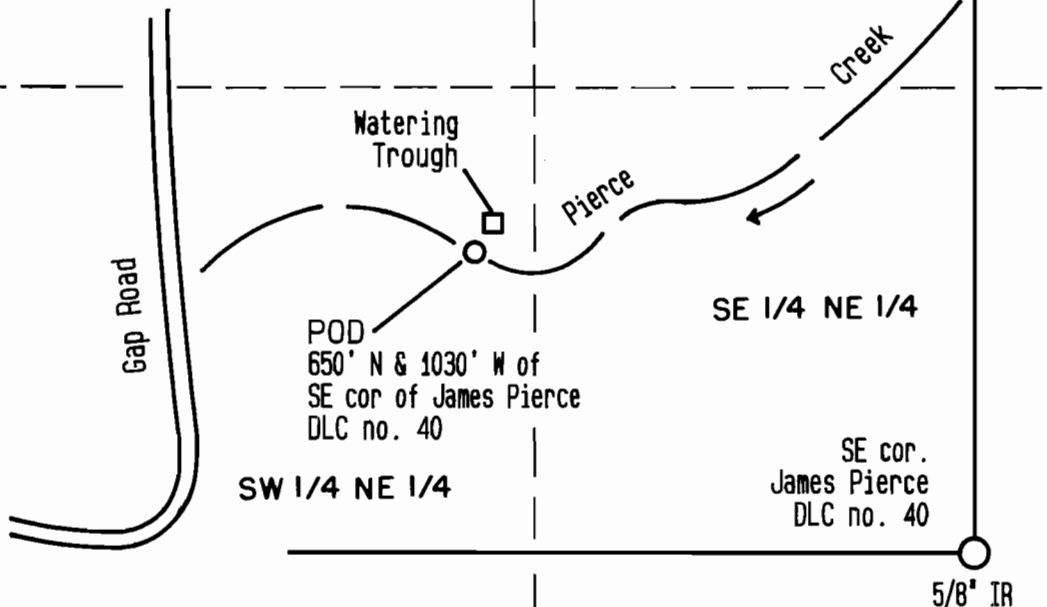

FINAL PROOF SURVEY

1/4
cor.

Application no. 69194
Permit no. 50100
MAXINE G. or DONALD F. LYNCH
Surveyed March 21, 1988
Surveyed by W.C. Bowne, Eugene, OR
See attached narrative

