

T. 17 S., R. 3 W., W. M.


RECEIVED RECEIVED

MAR 21 1990

FEB 13 1990

WATER RESOURCES DEPT. SALEM, OREGON


WATER RESOURCES DEPT. SALEM, OREGON

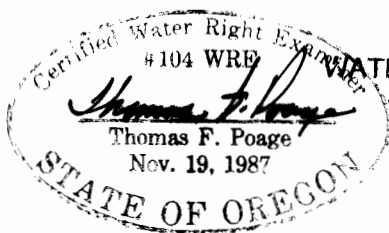

RECEIVED

MAR 21 1990

WATER RESOURCES DEPT. SALEM, OREGON

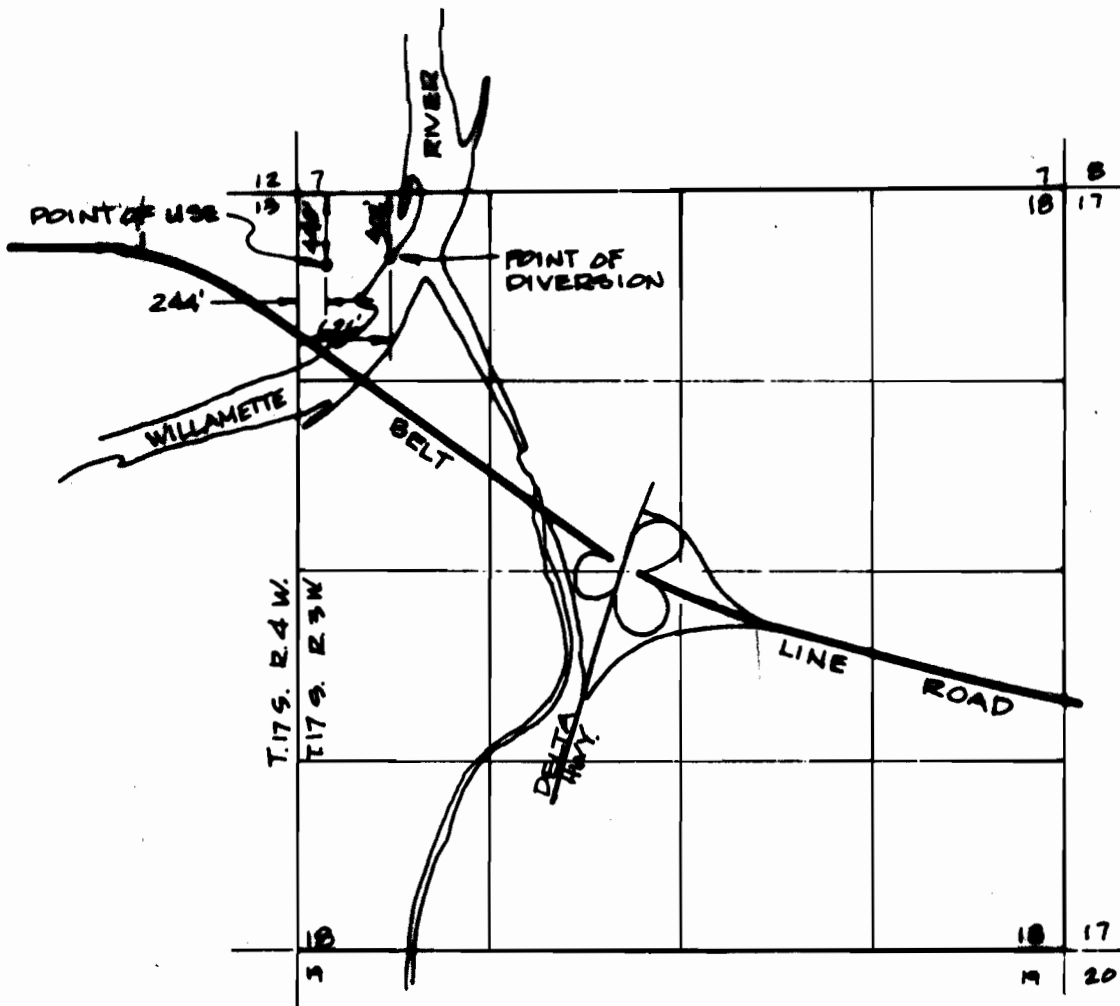

SCALE: 1" = 1320'

FINAL PROOF SURVEY

APPLICATION NO. 69219, PERMIT NO. _____

IN NAME OF

DELTA SAND & GRAVEL CO.

SURVEYED 9-27-89 BY TOM POAGE ENGINEERING