


T35S, R1W W.M.

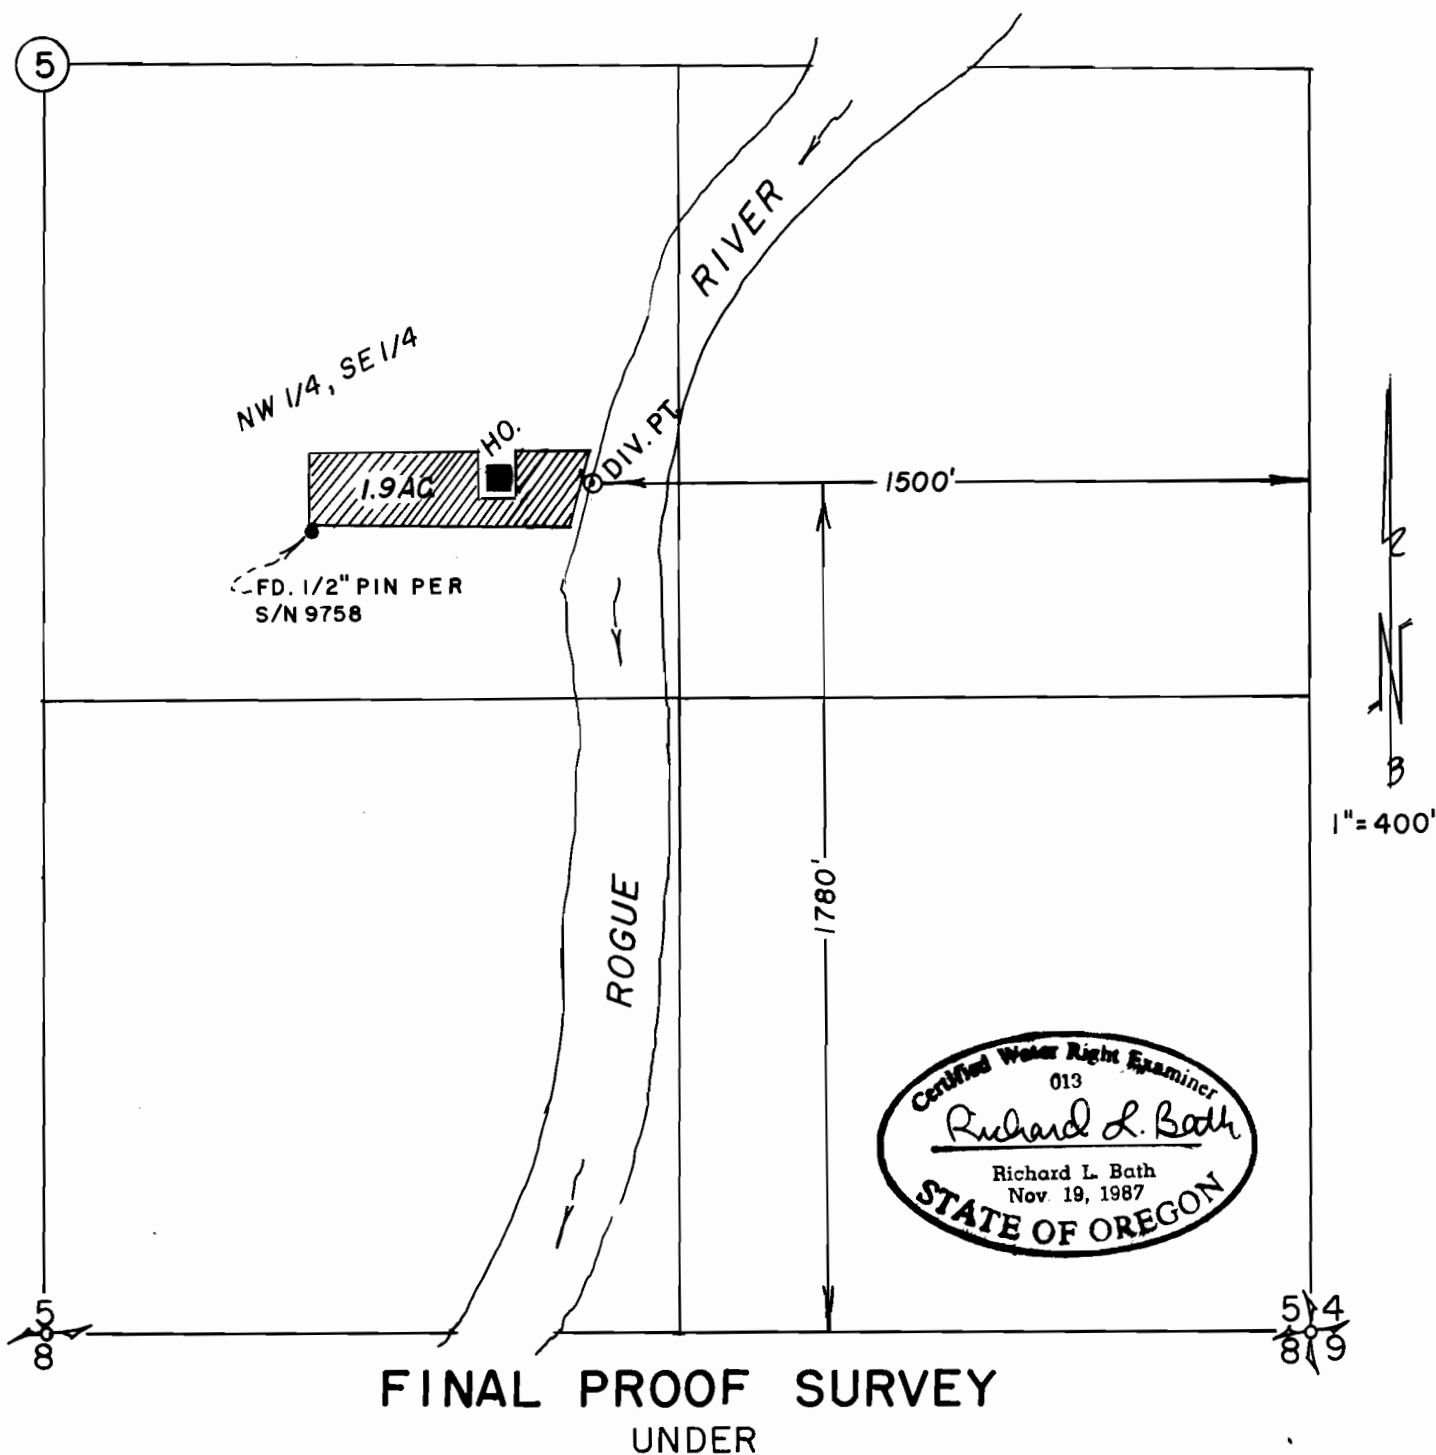

Application No. 69335

Permit No. 50144

IN NAME OF
PAT WOLFORD
35-1W-05-T.L.1100

Surveyed May 25, 1989
By Richard L. Bath
Richard L. Bath
CWRE No 013