


T. 11 S., R. 5 W., W.M.  
SECTION 4

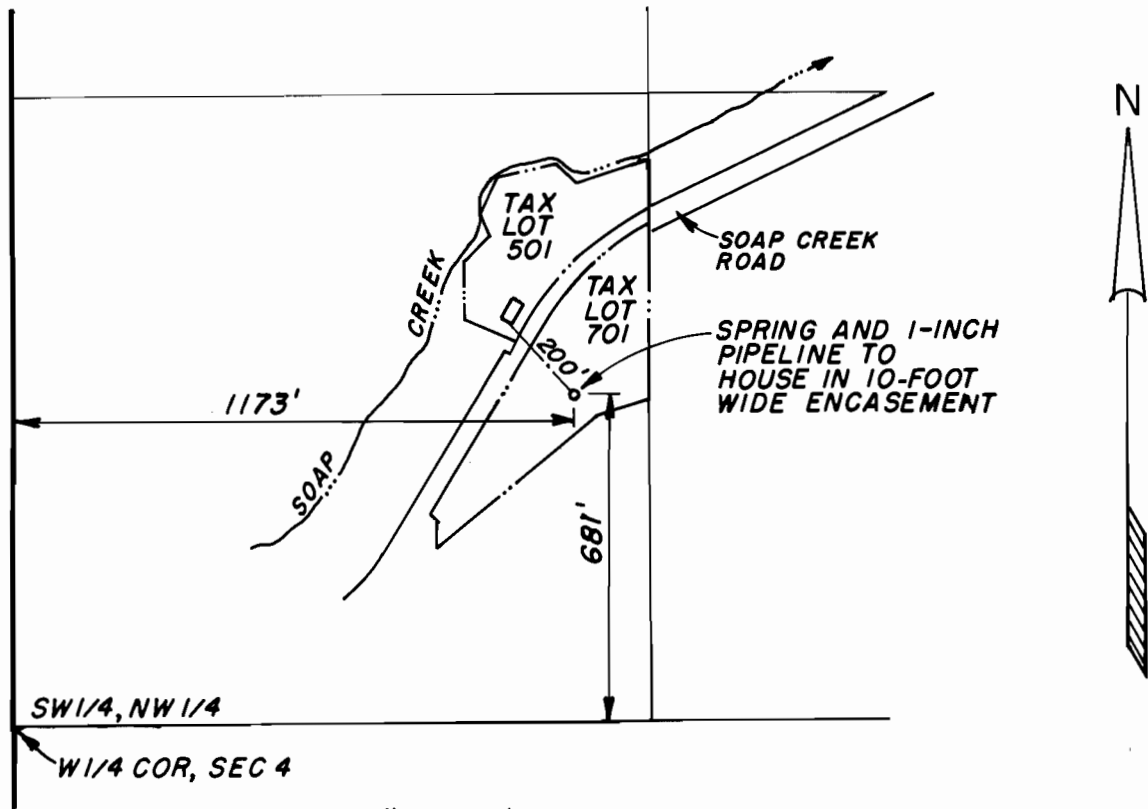

SCALE: 1" = 400'


**FINAL PROOF SURVEY**  
UNDER

Application No. 69984 Permit No. 50951...

IN NAME OF

**CAROLINE BUCHANAN**

Surveyed Mar. 10, 1991, by .....

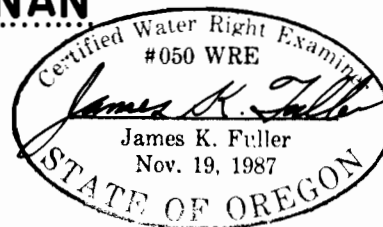

THE PURPOSE OF THIS MAP IS TO IDENTIFY THE LOCATION OF THE WATER RIGHT. IT IS NOT INTENDED TO PROVIDE INFORMATION RELATIVE TO THE LOCATION OF PROPERTY OWNERSHIP BOUNDARY LINES.