


T 34 S, R 14 W, W.M.

JAN 15 1991

ET 20 1990

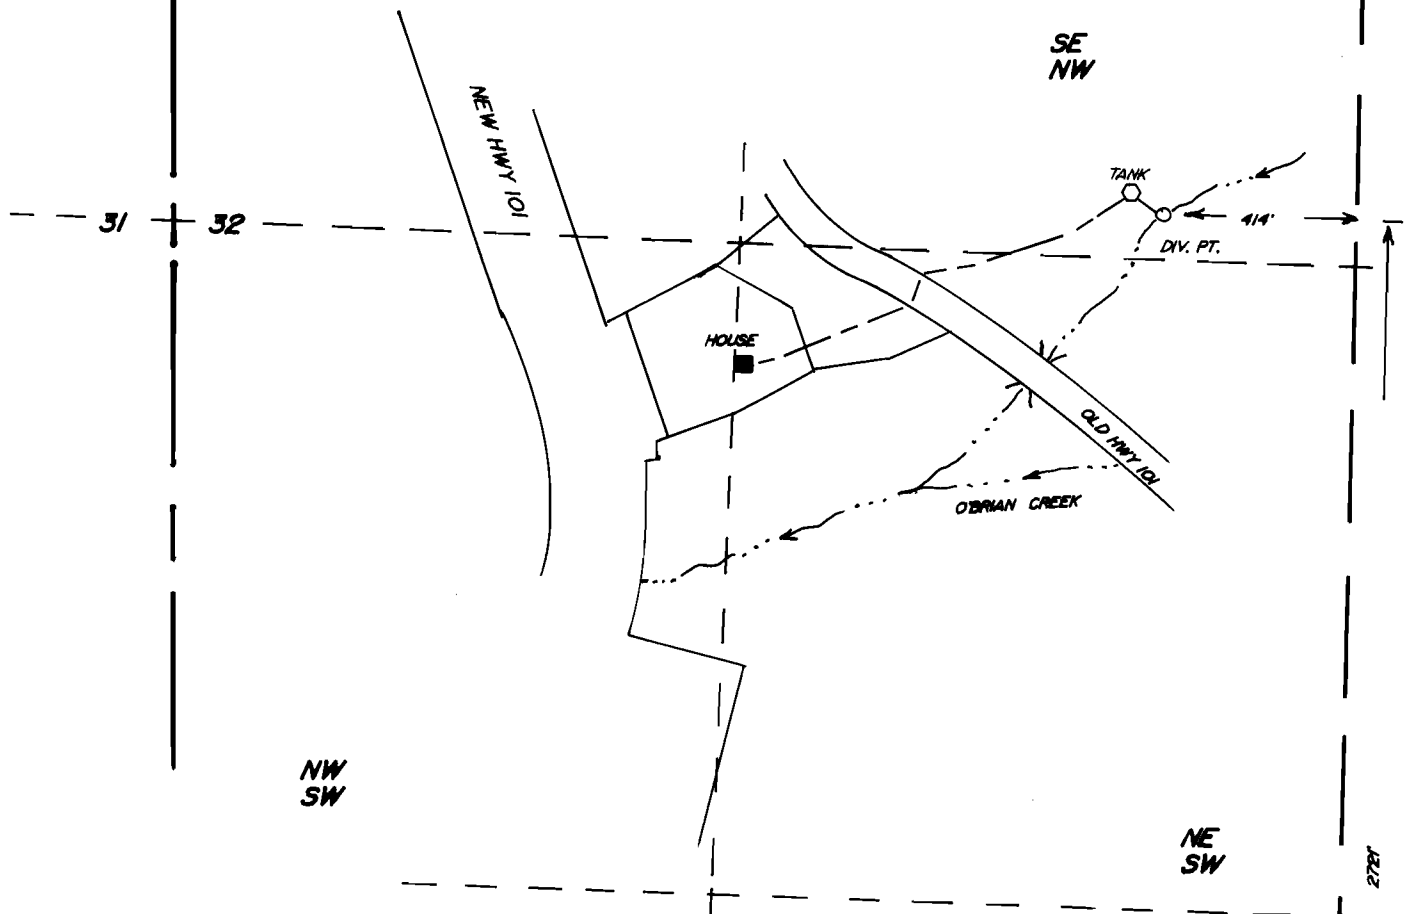

The preparation of this map was for the purpose of identifying the location of the proposed water right and has no intent to provide dimensions or location of property lines.

FINAL PROOF SURVEY UNDER

Application No. 70146 Permit No. 50862

In name of


Jospeh G. & Patricia Gulick

Scale - 1" = 400'

Surveyed July 25, 1990

By :

HJ Newhouse

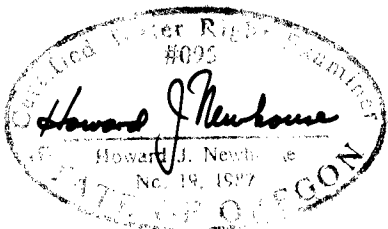

32

5

BCIP