




T. 36 S., R. 1 W., W.M.

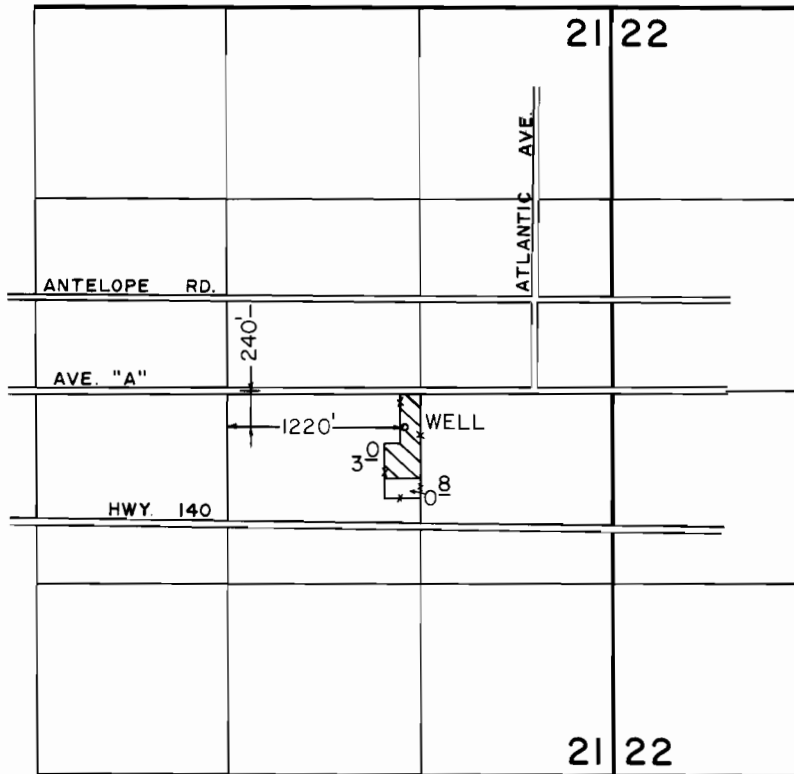

SCALE: 1" = 1320'

FINAL PROOF SURVEY UNDER

Application No. G-6715.. Permit No. G-6254..
IN NAME OF

DARRELL & JAYNE ROUSH

Surveyed APRIL 26 1989, by B. S. JAMES.