


6-8203  
65690

T. 39 S., R. 11 E., W.M.

SECTION 13

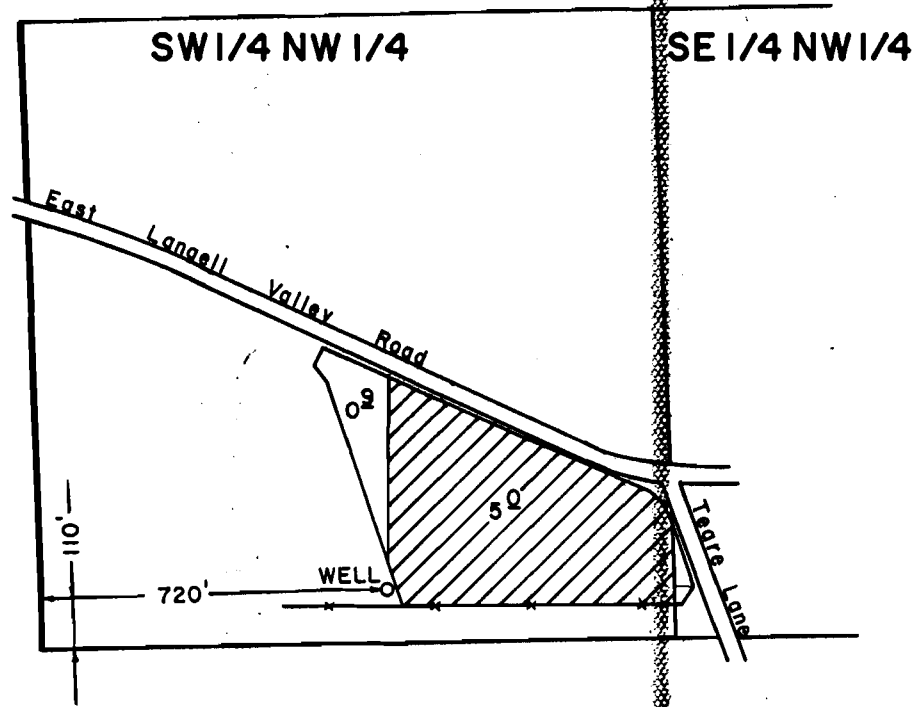

SCALE: 1" = 400'

**FINAL PROOF SURVEY**  
UNDER

Application No. G-8798 Permit No. G-8203  
IN NAME OF

TED M. & MARIE V. HARRIS

Surveyed APRIL 13 1990, by D.W. SPARKS

6-1-90  
PTS *gk*