

RECEIVED

AUG 24 1981



WATER RESOURCES DEPT
SALEM, OREGON

RECEIVED

JUL 14 1980

WATER RESOURCES DEPT
SALEM, OREGON

10-52

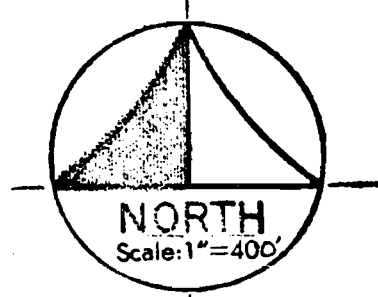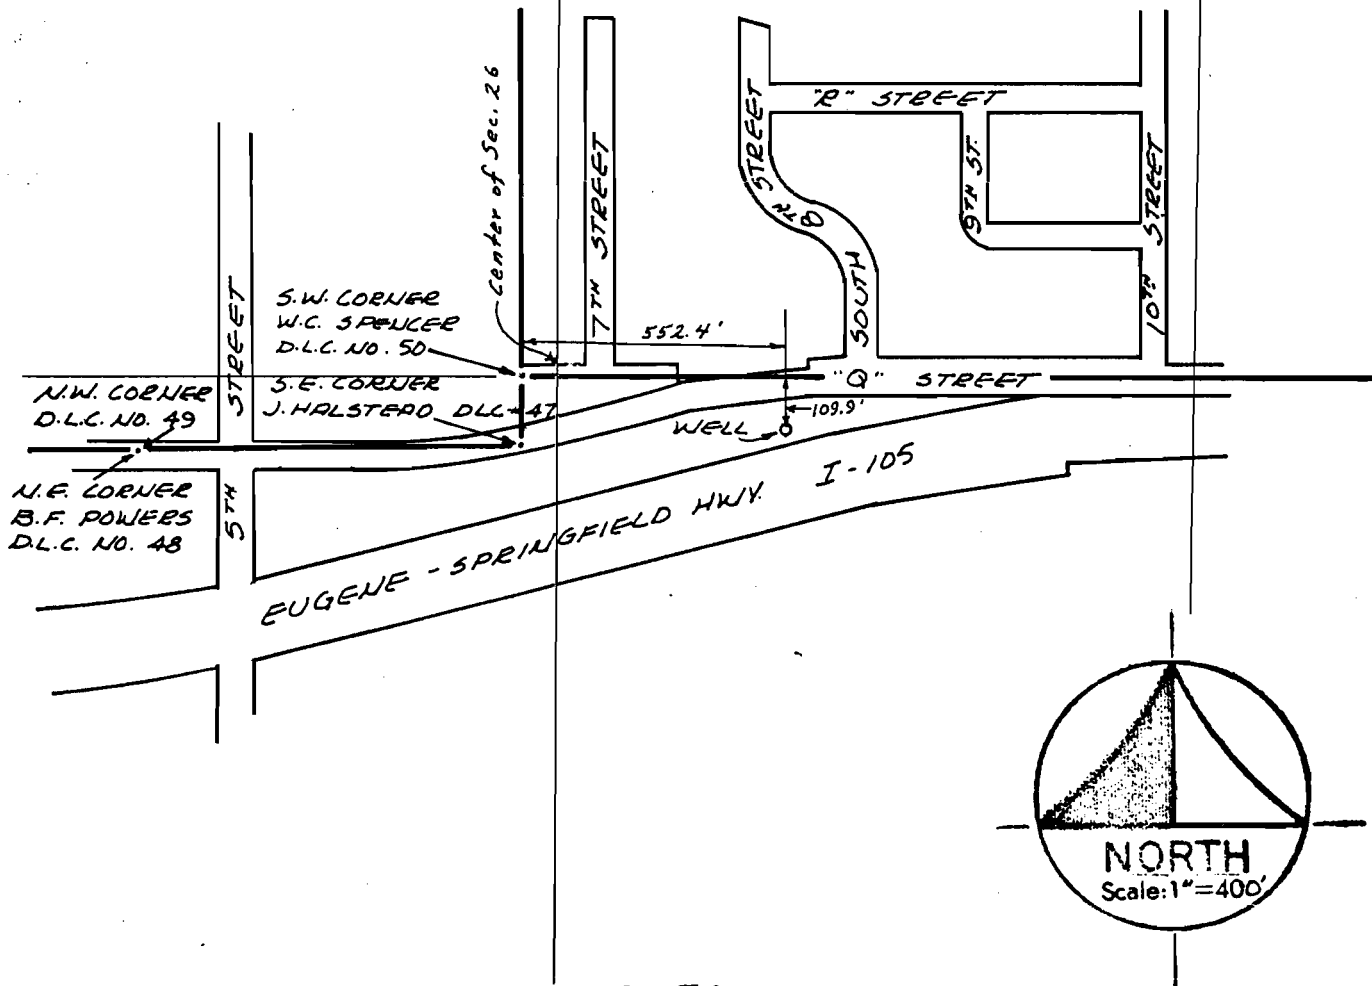

WATER RIGHTS MAP

CLIENT: RAINBOW WATER DISTRICT

LOCATION: SE 1/4, SEC. 26, T. 17S., R. 3W., W. 1/4
SPRINGFIELD, LANE COUNTY, OREGON

PREPARED BY: PLANTS & ASSOCIATES 686-9211
54 CENTENNIAL LOOP
EUGENE, OREGON 97401

Application No. *H 9832*
Permit No. *G 9945*