


T.3S.,R. 40E.W.M.

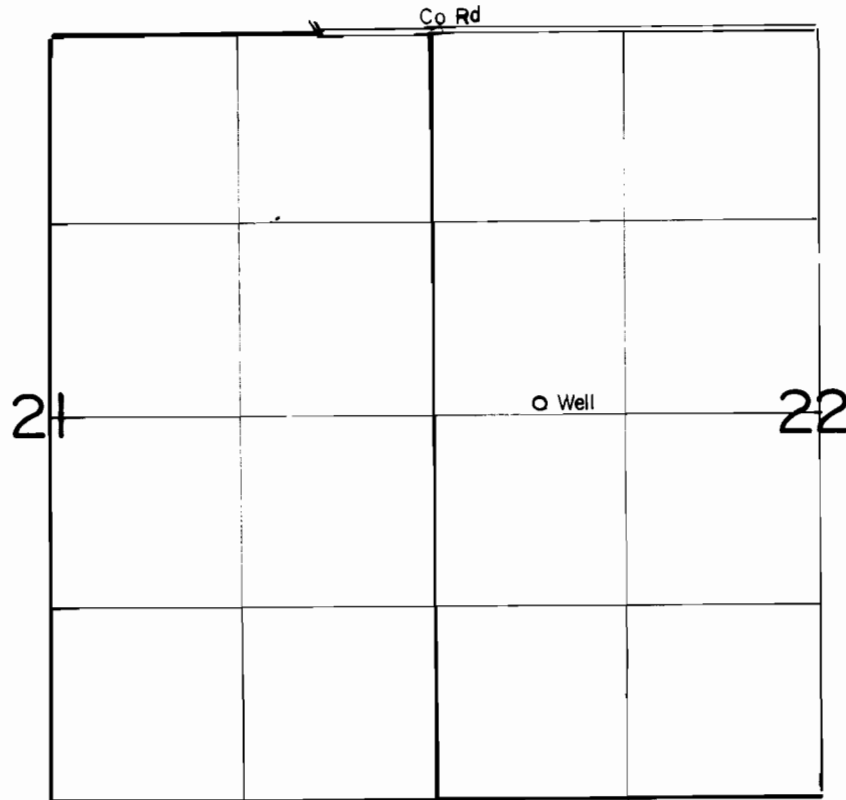

Well Located 60' N & 740' E From W1/4 Corner Of Section 22.

SCALE: 1"=1320'

**FINAL PROOF SURVEY
UNDER**

**Application No. G-10386 Permit No. G-9580.....
IN NAME OF**

.....**CITY**.....**OF**.....**COVE**.....

Surveyed JUNE 14.. 1990., by H.B. HADDEN.....