


T. 8 S., R. 2 W., W.M.

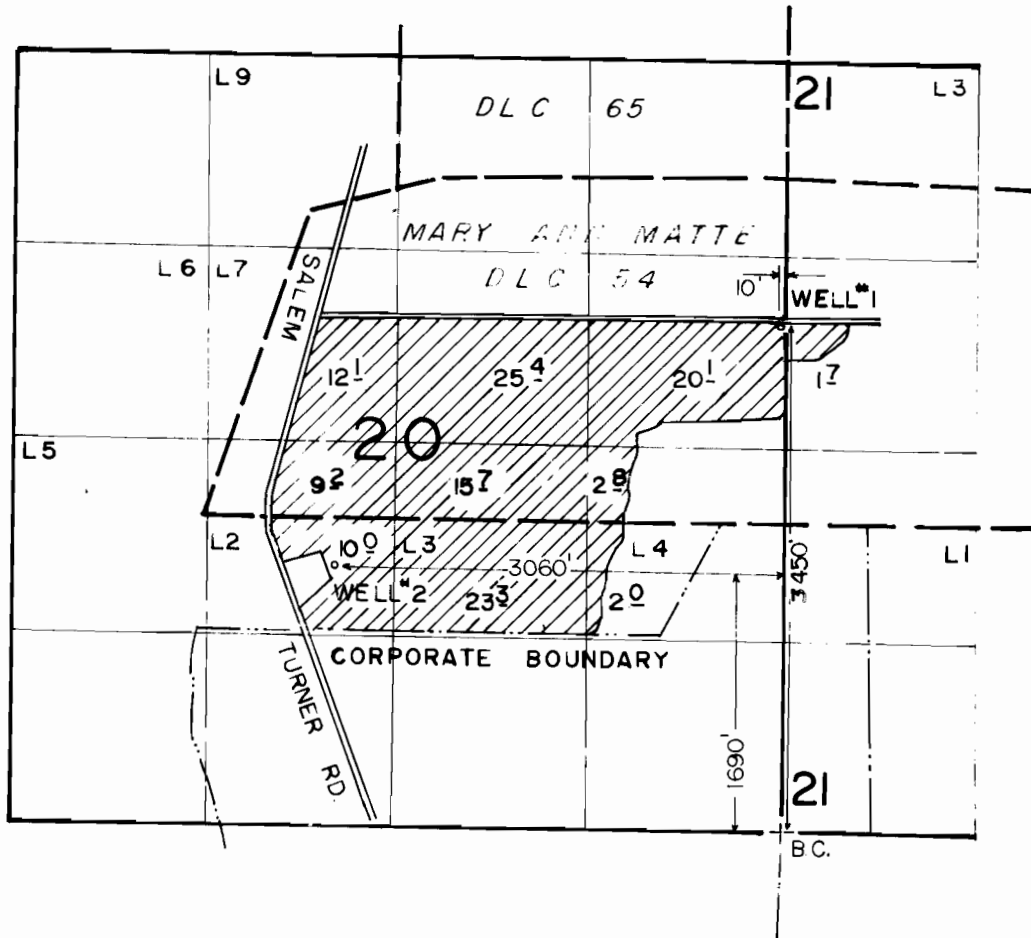

**FINAL PROOF SURVEY**  
**UNDER**

Application No. G-10701 Permit No. G-9927  
IN NAME OF

ANGELIKA SPALT

Surveyed NOV. 14 19.90, by J.M. SCHMORDE

12-3-90  
DFN-IP-19