


G-10547  
65697

# T. 39 S., R. 8 E., W.M.

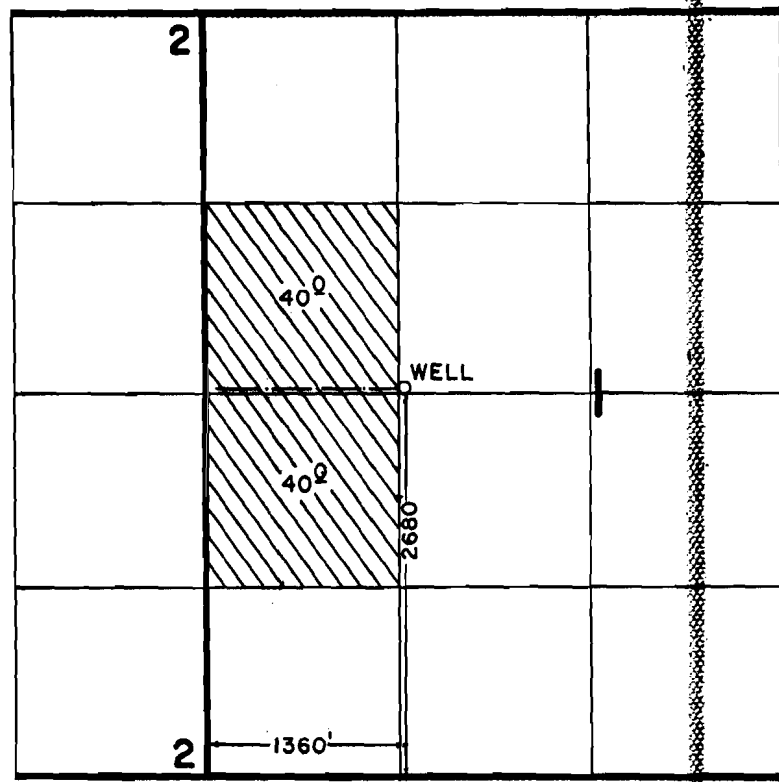

Alomath No. 2 Well



SCALE: 1" = 1320'

## FINAL PROOF SURVEY UNDER

Application No. G-11453 Permit No. G-10547  
IN NAME OF

..... EDGAR J. BLODGETT .....

Surveyed APRIL 10 1990., by B. W. BISHOP

5-21-90  
41035-178-184D *fel*