




T. 2 S., R. 1 W., W.M.

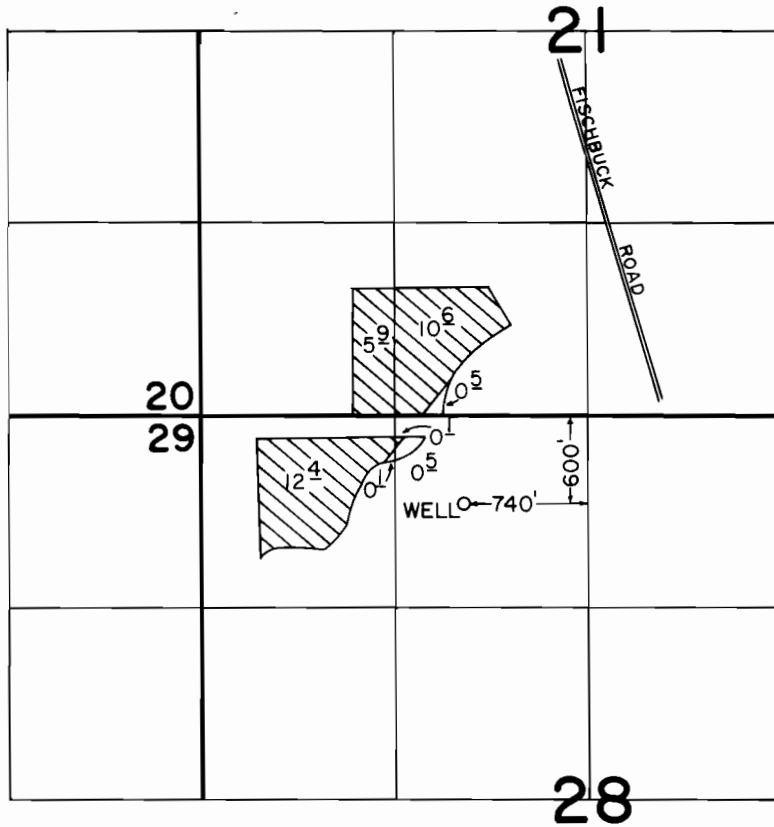

SCALE: 1" = 1320'

FINAL PROOF SURVEY
UNDER

Application No. G-11474 Permit No. G-10595...
IN NAME OF

JOHN D. GALBREATH & JOSEPH A. GALBREATH

Surveyed JUNE 8... 1989., by T.M. WARREN....