
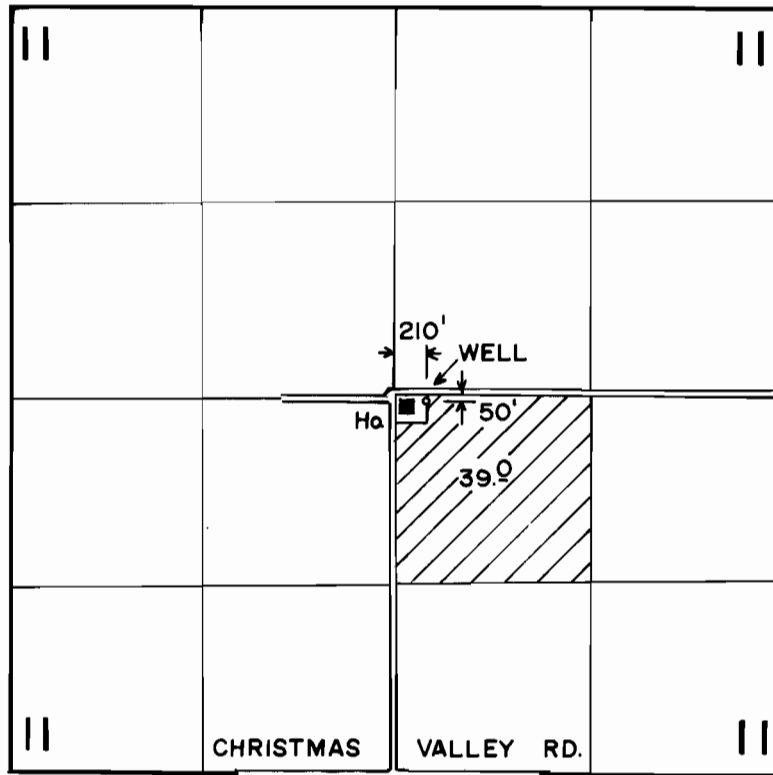


T. 27 S., R. 17 E., W.M.

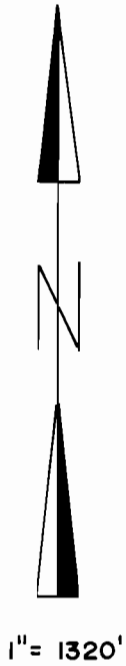

**FINAL PROOF SURVEY  
UNDER**

Application No. G-11496 Permit No. G-10782  
IN NAME OF

CARL HENSELEY

Surveyed JUNE 5, 1990, by B.W. BISHOP

8-13-90 DSM  
41037-379-196R