


T.40S.,R.8W.,W.M.

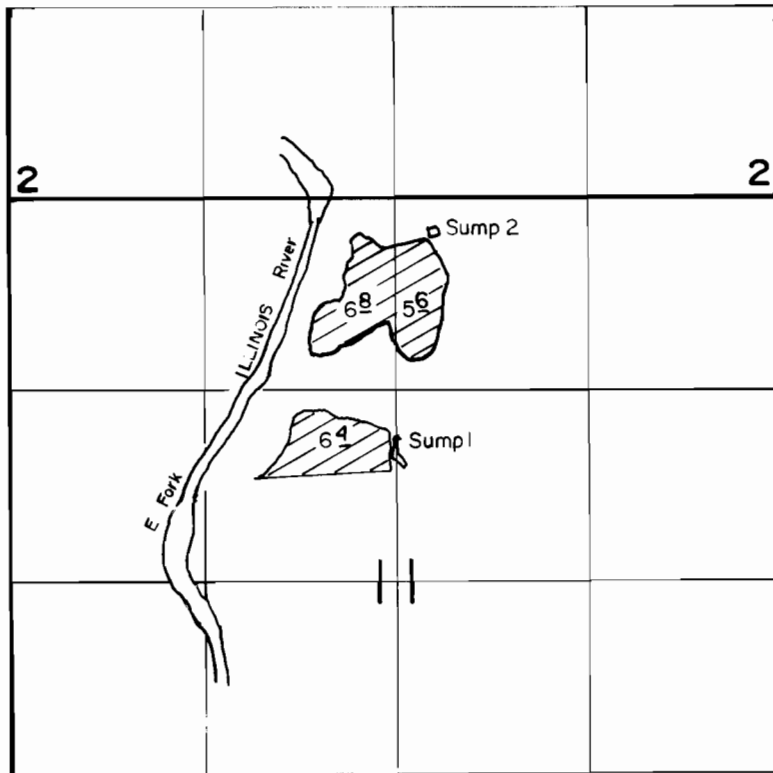

Sump1-1650' S, Sump2-220'S&250'E,Both From N1/4 Corner Of Section 11

SCALE: 1"=1320'

FINAL PROOF SURVEY UNDER

Application No. G:11537.. Permit No. G:10685....
IN NAME OF

.....JOHN..... P..... JARNAGIN.....

Surveyed MAY.22.. 1990., by B.S.JAMES.....