



**NW 1/4 OF SE 1/4
SECTION 2
T.2 S R.2 E. W.M.**

ACREAGE BY USE:


CONTAINERIZED
NURSERY STOCK
= 13.35 AC.

GREENHOUSES
= 2.8 AC.

RELATED NURSERY
= 0.40 AC.

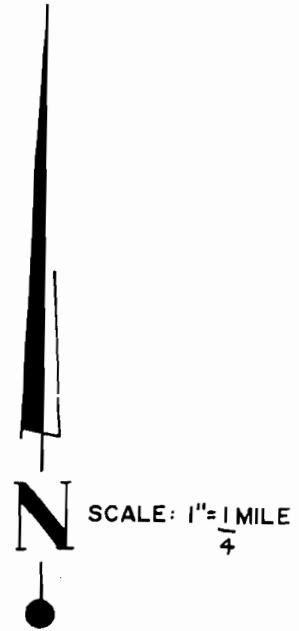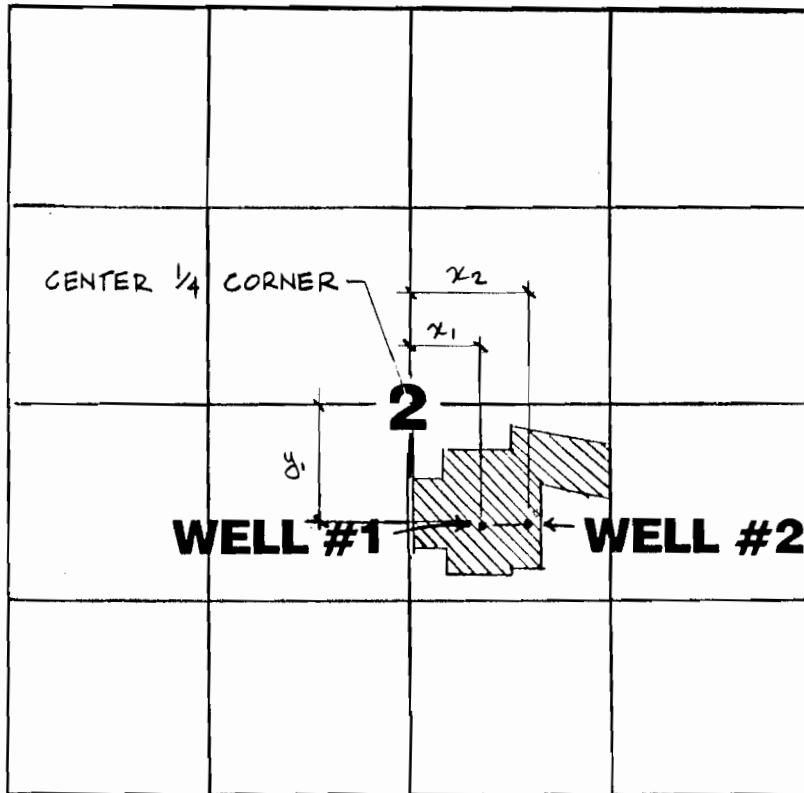

$y_1 = 776.96'$
 $x_1 = 372.00'$
 $x_2 = 847.00'$

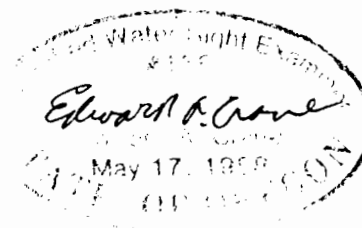

FINAL PROOF SURVEY

UNDER

APPLICATION NO. G11739. PERMIT NO. G-10868
 IN THE NAME OF

**RHODODENDRON NURSERY INC
 STEPHEN G. SAVAGE, PRESIDENT**

SURVEYED JUNE 14, 1989 BY *Edward P. Crane*