
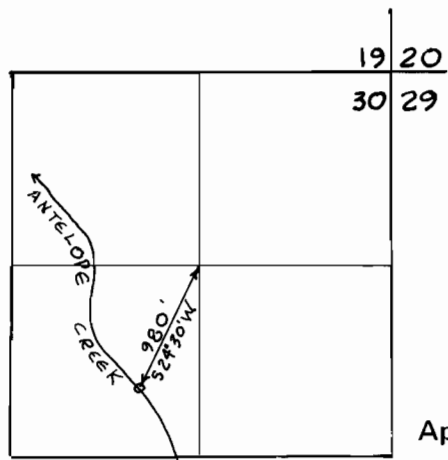
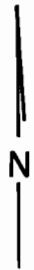


T. 36 S., R. 1 W., W. M.

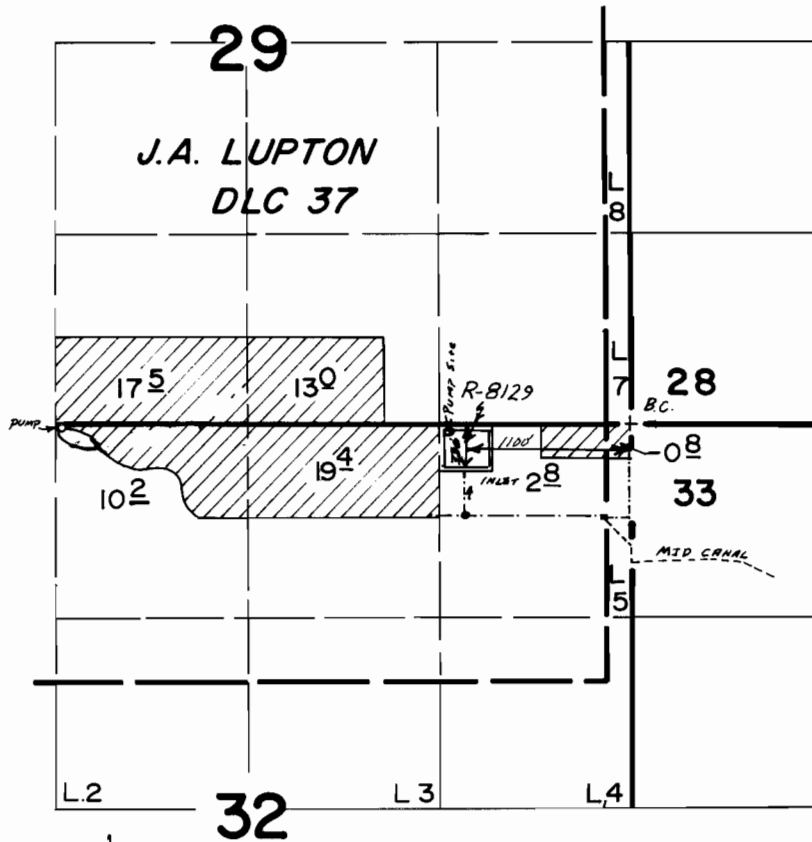

T 36 S R 1 E W M

Scale 1" = 1320'

FINAL PROOF SURVEY

UNDER

49237

41303

R-59701

R-8129

Application No. 59702... Permit No. 44834....

IN NAME OF

.....CRATER LAKE ORCHARDS.....

Surveyed JUNE 15 1984, by B.S. JAMES.....