T. 36 S., R. 1 W., W. M.

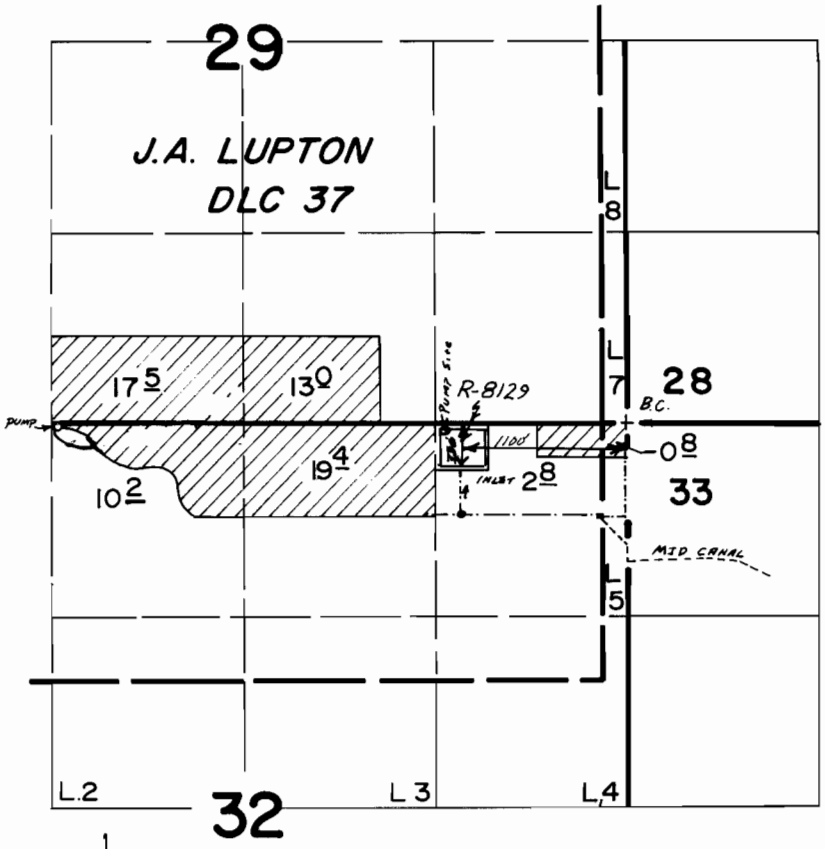

N

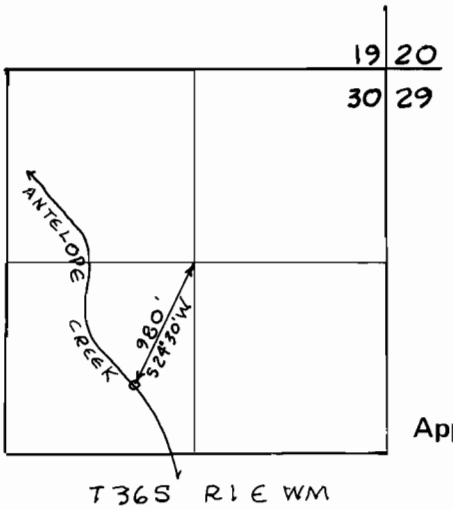

Scale 1" = 1320'

FINAL PROOF SURVEY

UNDER

49237 R-59701 41303 R-8129

Application No. 59702 Permit No. 44834

IN NAME OF

CRATER LAKE ORCHARDS

Surveyed JUNE 15 1984, by B.S. JAMES

41029-279-245R DLM 3-28-90