




T. 28 S., R. 13 W., W.M.

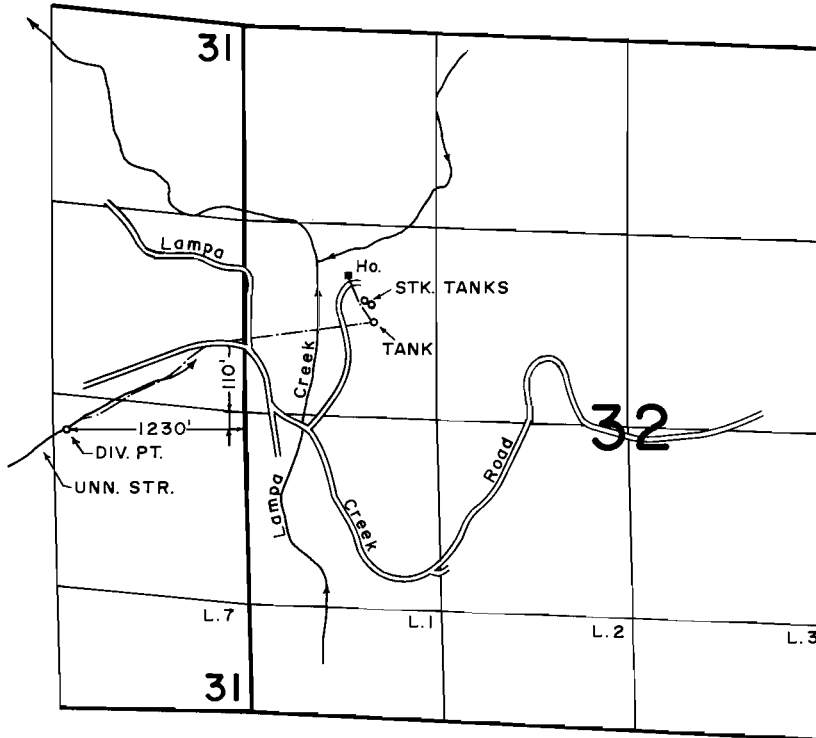

SCALE: 1" = 1320'

FINAL PROOF SURVEY UNDER

Application No. 50347... Permit No. 38008.....
IN NAME OF

.....**GEORGE L. PLUM**.....

Surveyed APRIL 10, 1990, by B. S. JAMES.....