


T.25S.,R.12W.,W.M.

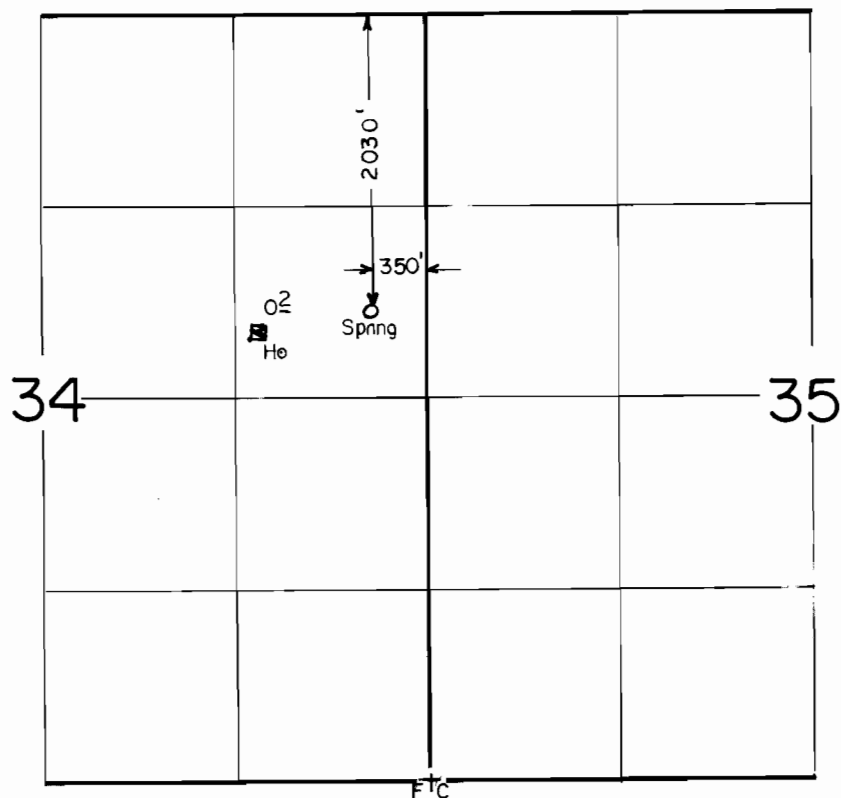

SCALE: 1"=1320'

FINAL PROOF SURVEY
UNDER

Application No. 51307.... Permit No. 39124.....
IN NAME OF

.....**CARL A. GRANICH**.....

Surveyed JULY...12.... 1989., by J.M. SCHMORDE....