


T.8S. R.46E. W.M.

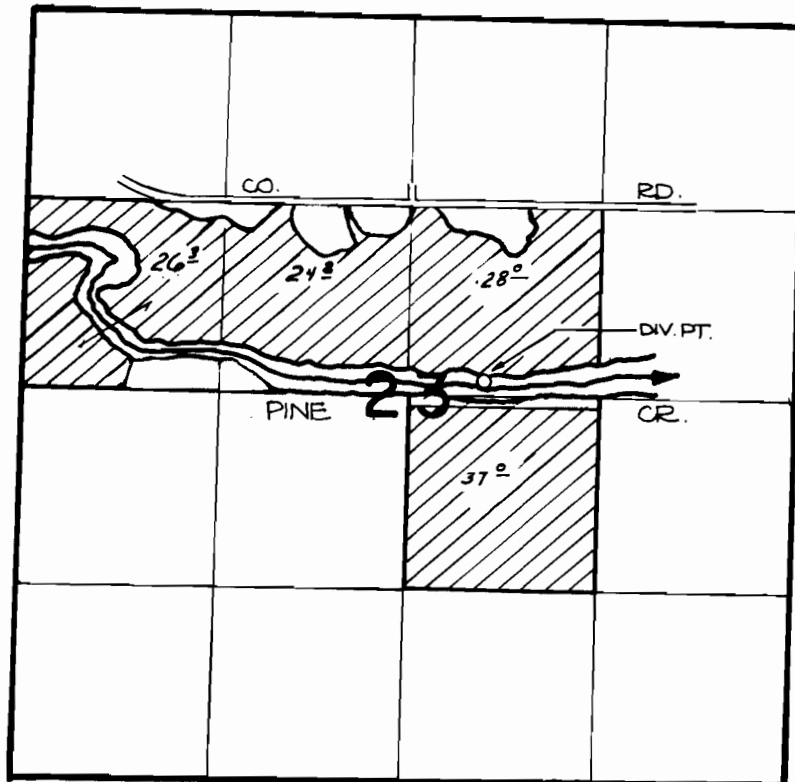

POINT OF DIVERSION IS LOCATED 2475' S. AND 3125' E. FROM THE N.W. CORNER OF SECTION 23.

FINAL PROOF SURVEY UNDER

Application No. **54902**. Permit No. **41185**.....
IN NAME OF

.....**C. R. GULICK**.....

Surveyed **AUG. 4**.... 19**83**, by **V. CHURCH**.....

*RE-DRAFT 1-16-91 DSM
BBB-2KK-168, BBB-9N-137
41001-179-62R PRP 12/13/83*