



T. 36 S., R. 2 E., W.M.

29

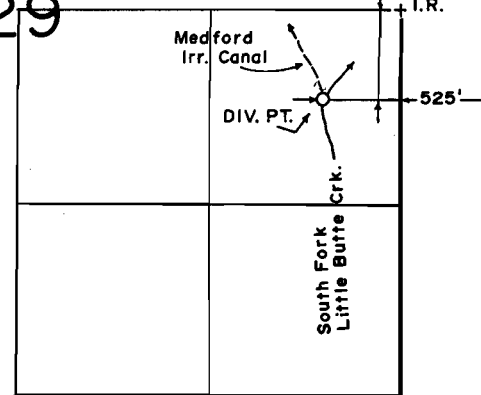

T. 37 S., R. 1 W., W.M.

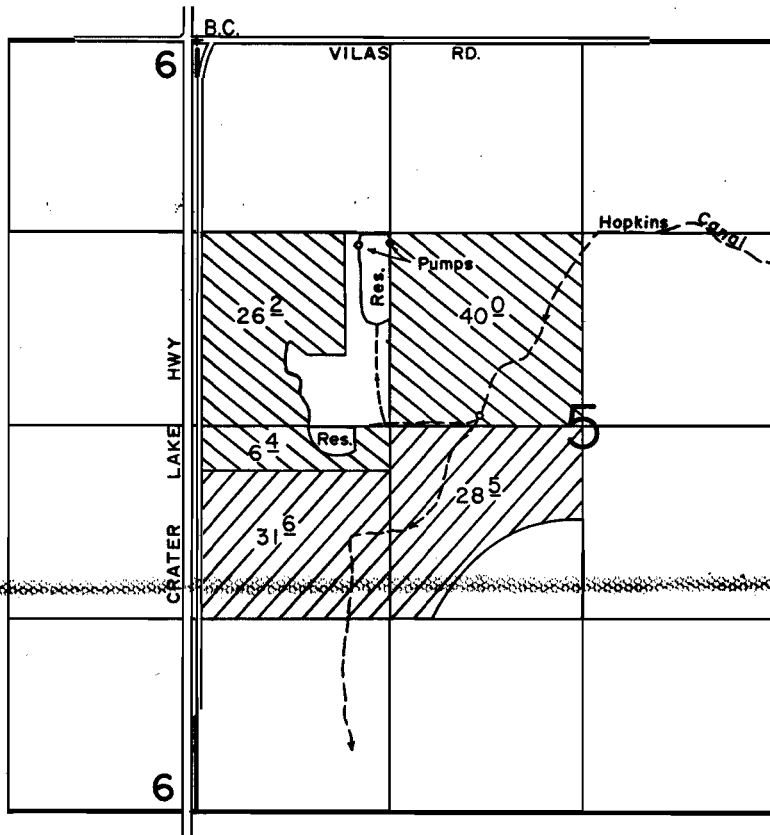

SCALE: 1" = 1320'

FINAL PROOF SURVEY

UNDER

R-59306	R-8144	
59307	44916	
R-60406	R-8265	

Application No. 60407 Permit No. 45723

IN NAME OF

EDWARD W. EARNEST &/OR STEVEN KERBY

Surveyed MAY 10 1989, by B. S. JAMES