



T. 36 S., R. 2 E., W.M.

29

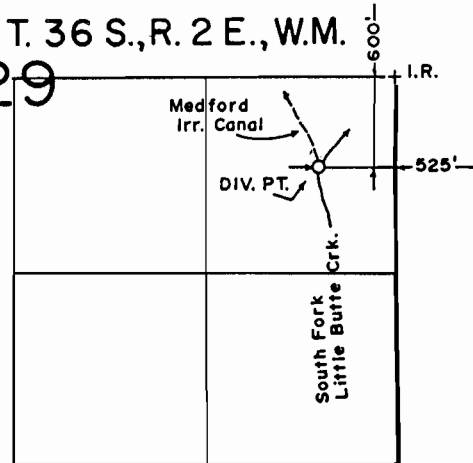

T. 37 S., R. 1 W., W.M.

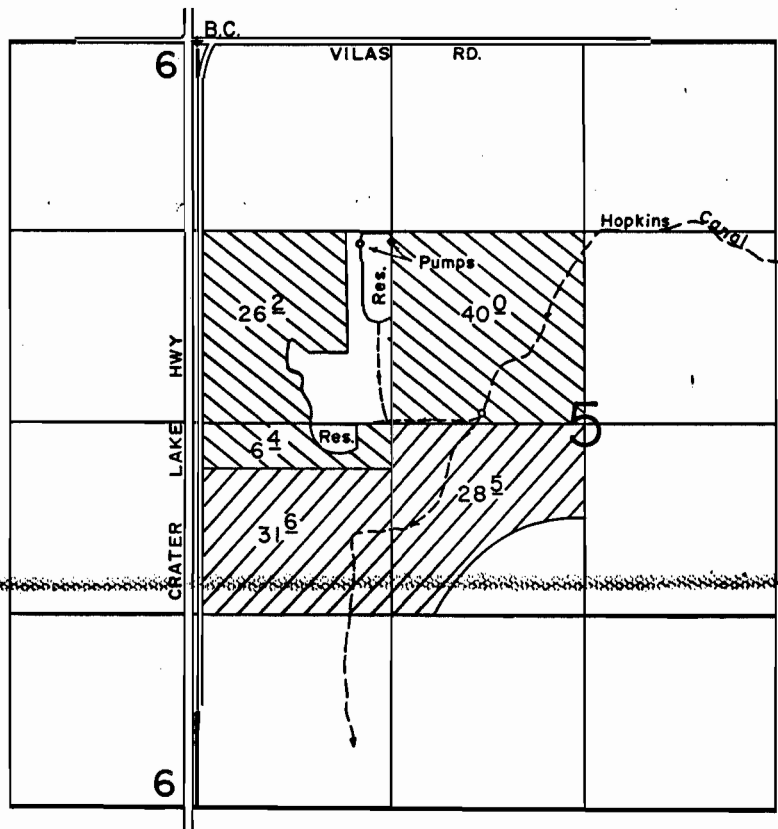

SCALE: 1" = 1320'

# FINAL PROOF SURVEY

UNDER

R-59306

59307

R-60406

R-8144

44916

R-8265



Application No. 60407.. Permit No. 45723.....

IN NAME OF

**EDWARD W. EARNEST &/OR STEVEN KERBY**

Surveyed MAY 10 1989, by B. S. JAMES.....

*fy*