90684

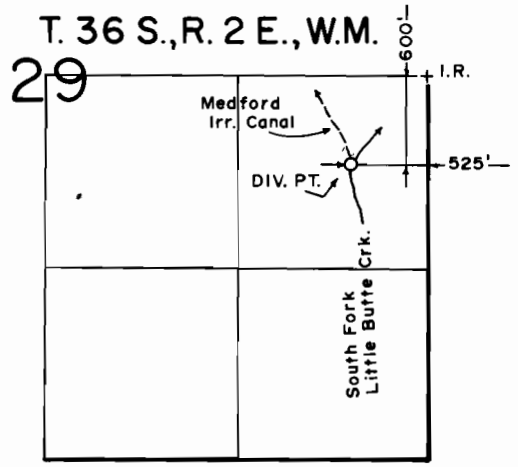

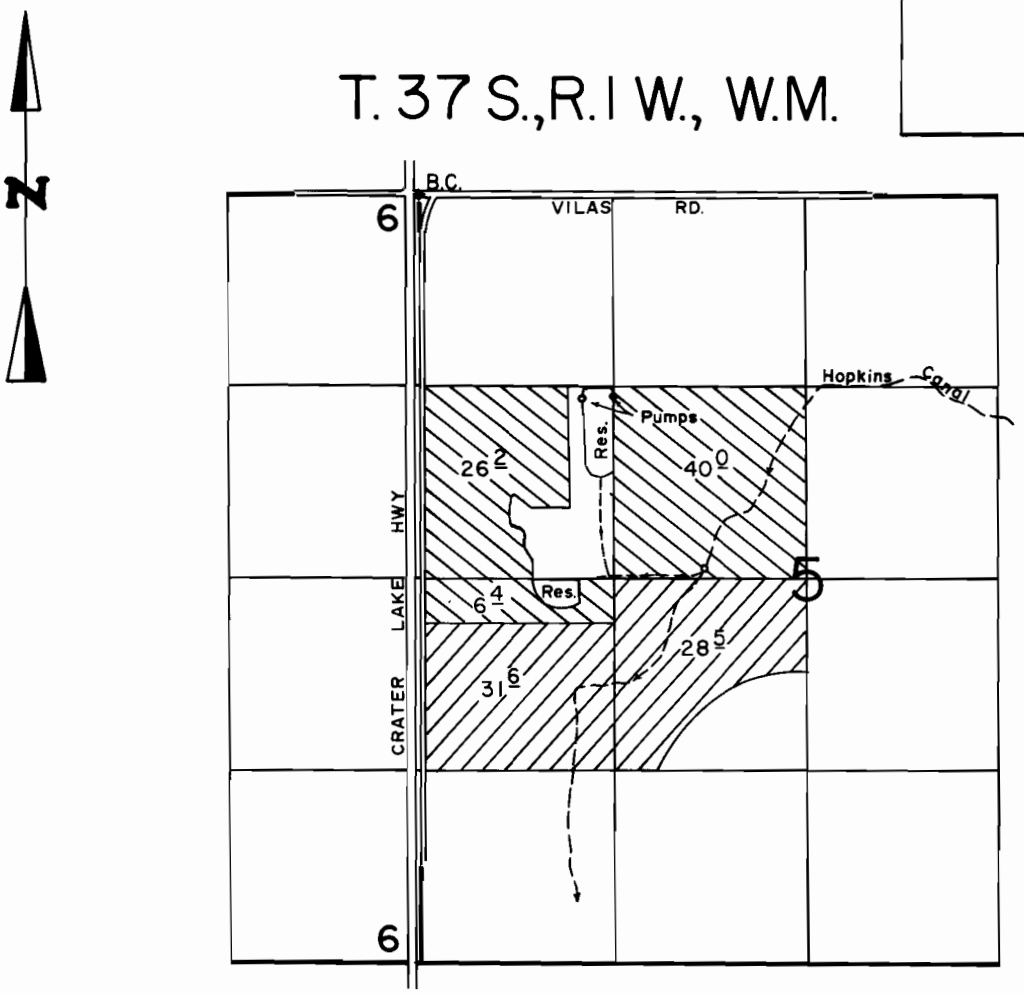

SCALE: 1" = 1320'

FINAL PROOF SURVEY

UNDER

R-59306	R-8144	
59307	44916	
R-60406	R-8265	
Application No. 60407	Permit No. 45723	

IN NAME OF

EDWARD W. EARNEST &/OR STEVEN KERBY

Surveyed MAY 10 1989, by B. S. JAMES

1-11-90

41029-279-244 R