



T. 36 S., R. 2 E., W.M.

29

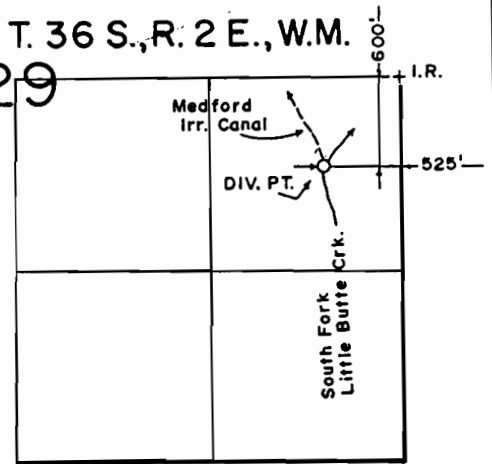

T. 37 S., R. 1 W., W.M.

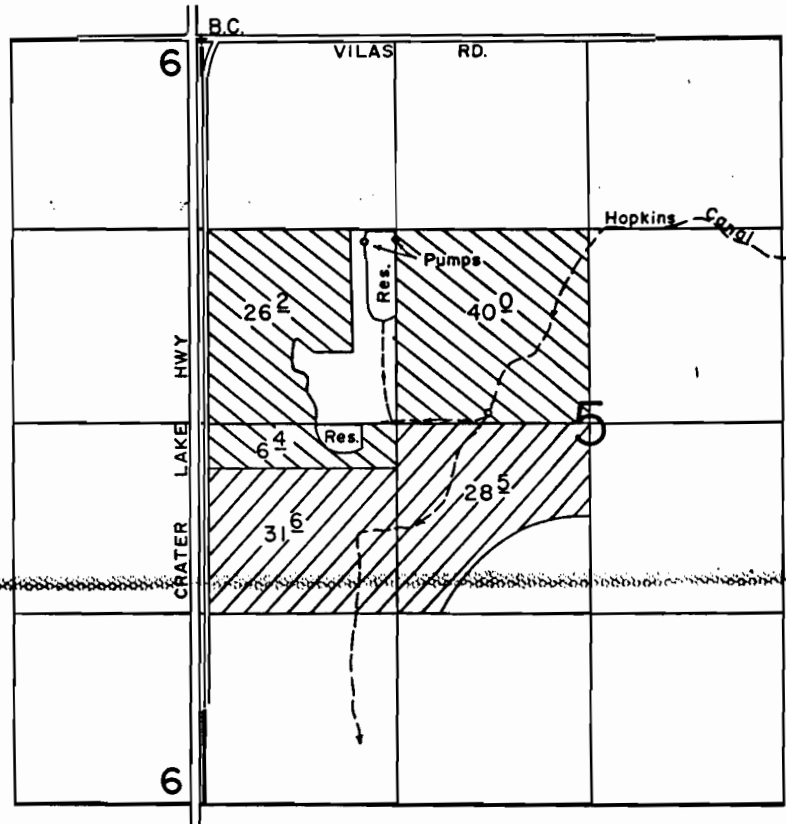

SCALE: 1" = 1320'

FINAL PROOF SURVEY

UNDER

R-59306

R-8144

59307

44916

R-60406

R-8265

Application No. 60407 Permit No. 45723

IN NAME OF

EDWARD W. EARNEST &/OR STEVEN KERBY

Surveyed MAY 10 1989, by B. S. JAMES