


T. 5 S., R. 4 W., W. M.

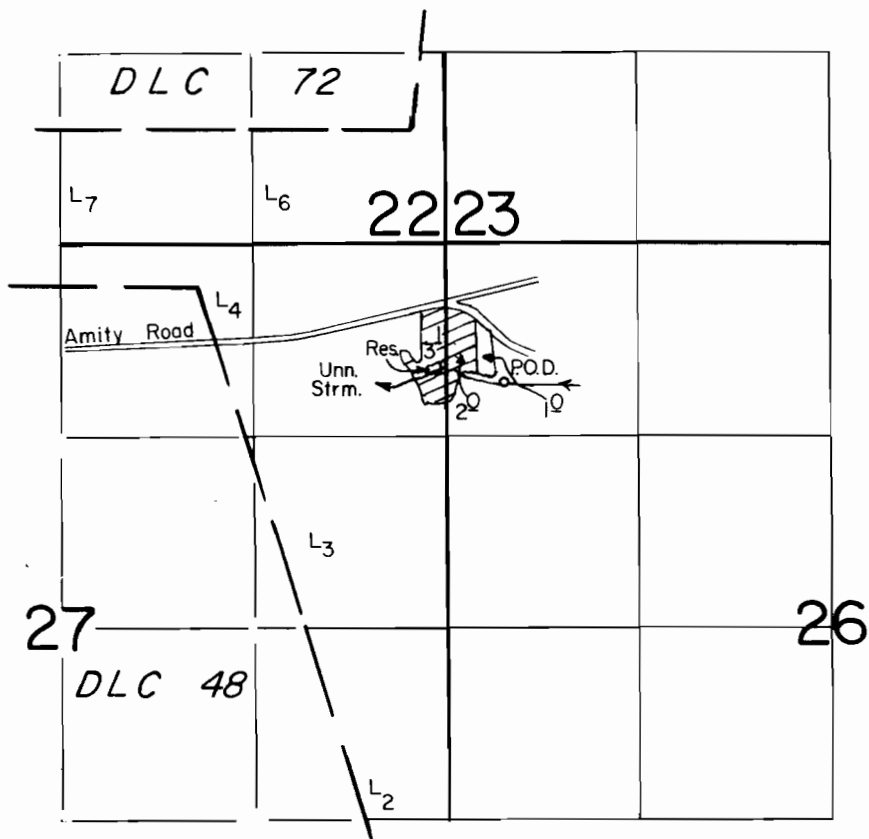

P.O.D. Loc. : 960' S. & 400' E. from NW Cor. Sec. 26

Scale: 1" = 1320'

FINAL PROOF SURVEY UNDER

R-59418 R-8100
Application No. 59407 Permit No. 44732
IN NAME OF

JOAN A. COOPER

Surveyed Sept. 8, 1988, by Z. Saleh
& Nov. 27, 1989, by T. Warren