


P-45107
C-65717

T.14 S., R.30 E., W.M.

N

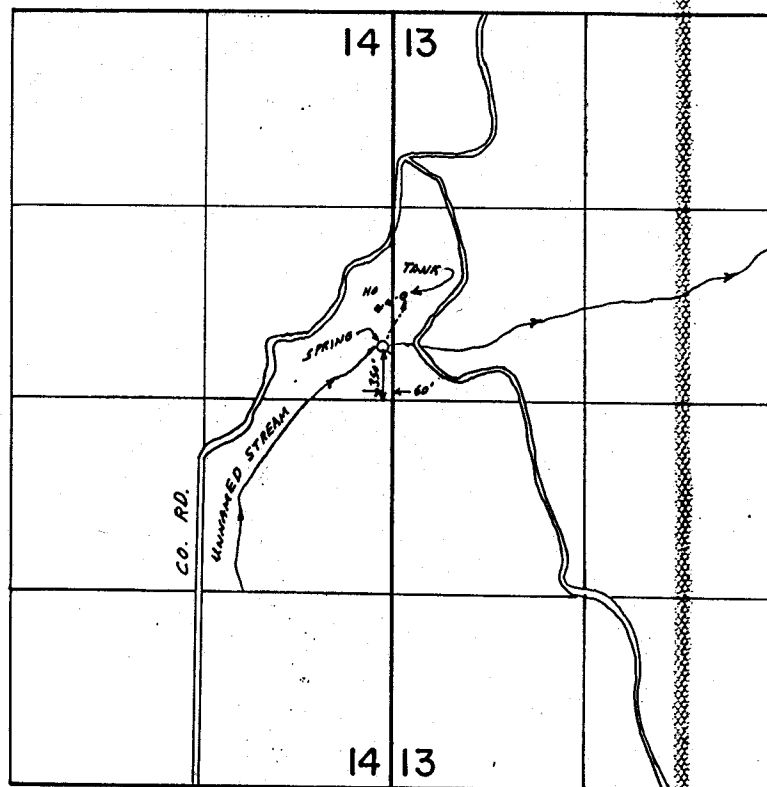

SCALE: 1"=1320'

FINAL PROOF SURVEY UNDER

Application No. 60423... Permit No. 45107...
IN NAME OF

RONALD K. QUINLIN

Surveyed JULY 6 1988, by Z.F. SALEH