


T. 28 S., R. 13 W., W.M.

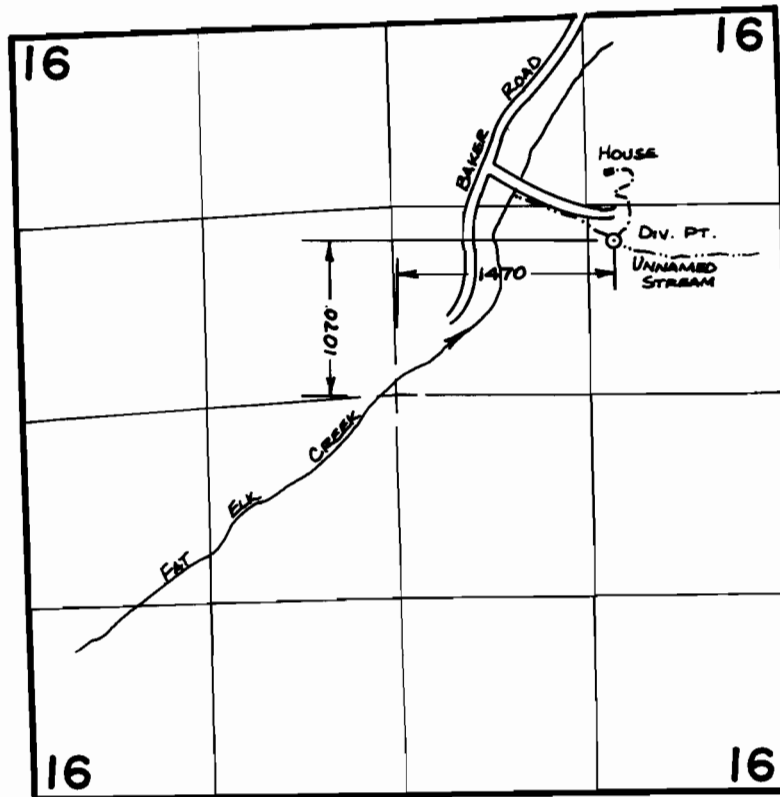

SCALE : 4" = 1 MILE

FINAL PROOF SURVEY UNDER

Application No. 60504 Permit No. 45332
IN NAME OF

GARRY VANPULLIAM

Surveyed 3/16 1988, by M. SCHMORDE