
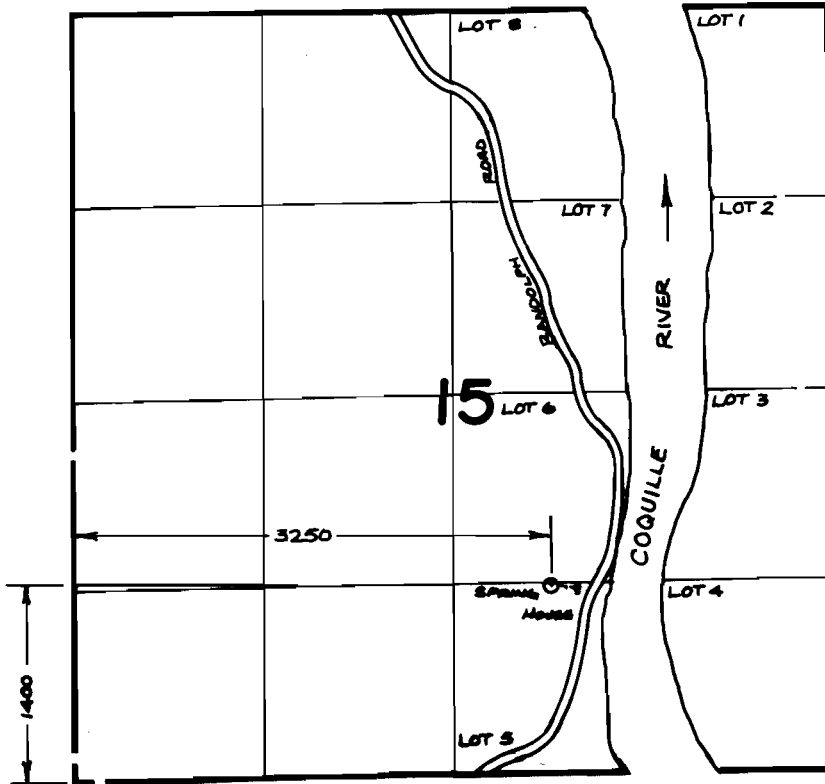


# T. 28 S., R. 14 W., W.M.

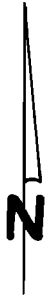

SCALE : 4" = 1 MILE

## FINAL PROOF SURVEY UNDER

Application No. ...60558. Permit No. ...45335...  
IN NAME OF

.....LARAMORE.....

Surveyed ....8/23... 19.88, by ...M. SCHMORDE..