


T. 28 S., R. 13 W., W.M.

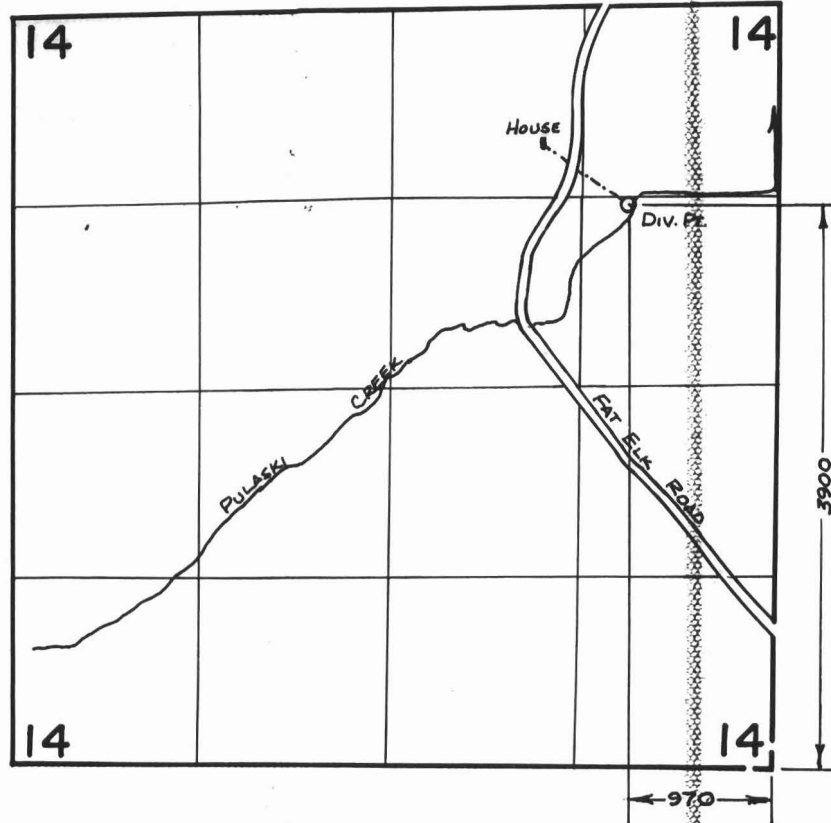

SCALE : 4" = 1 MILE

FINAL PROOF SURVEY UNDER

Application No. ...60725. Permit No. ...45412...
IN NAME OF

.....GERALD W. MARCA.....

Surveyed ...4/20... 19.88, by ...M. SCHMORDE...