


T.37 S., R.14 W., W.M.

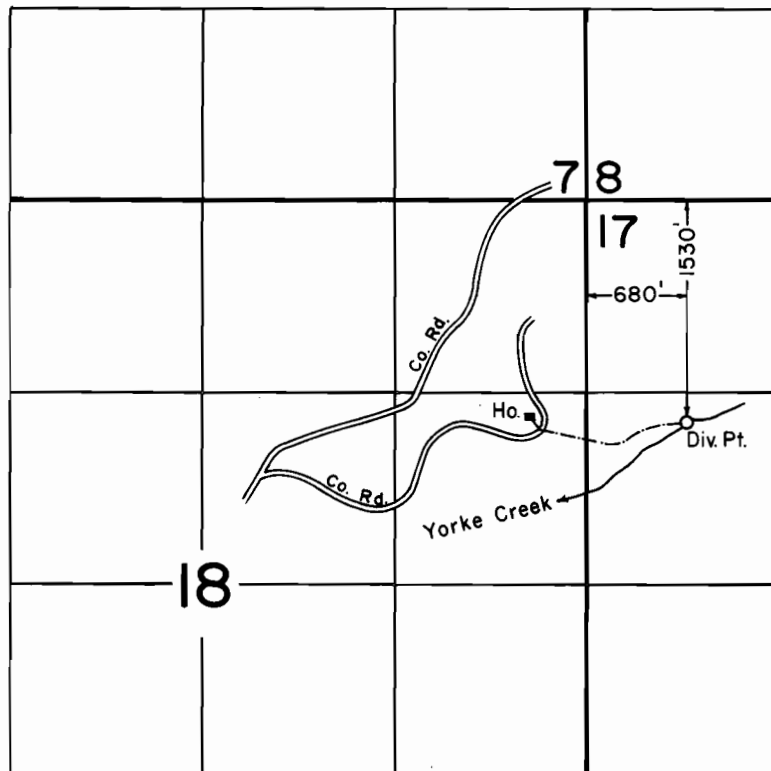

Scale 1"=1320'

FINAL PROOF SURVEY
UNDER

Application No. 60788 Permit No. 45387
IN NAME OF

WILLIAM P. SETH

Surveyed July 27, 1988, by B.S. JAMES