


T. 27 S., R. 13 W., W. M.

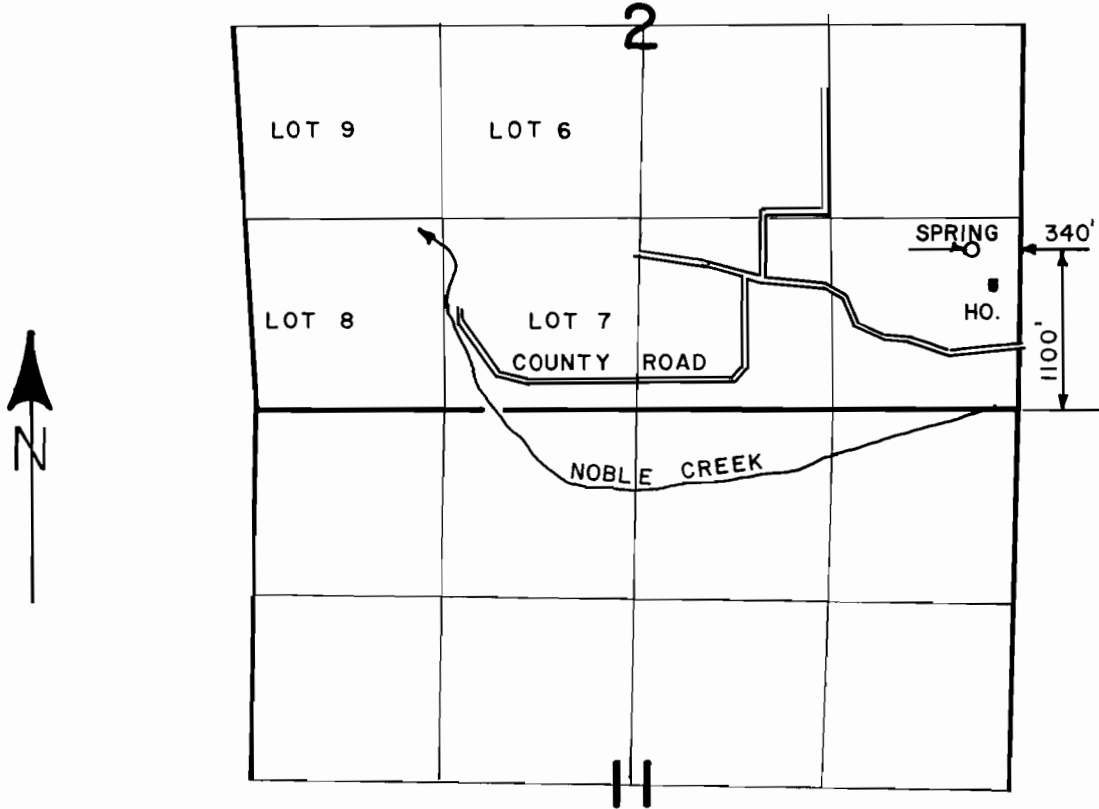

SCALE: 4" = 1 MILE

FINAL PROOF SURVEY
UNDER

Application No. 60976... Permit No. 45275.....
IN NAME OF

ROBERTA L. SEDIG

Surveyed MAR. 20. 1988, by J. M. SCHMORDE