


T. 35 S., R. 14 W., W. M.

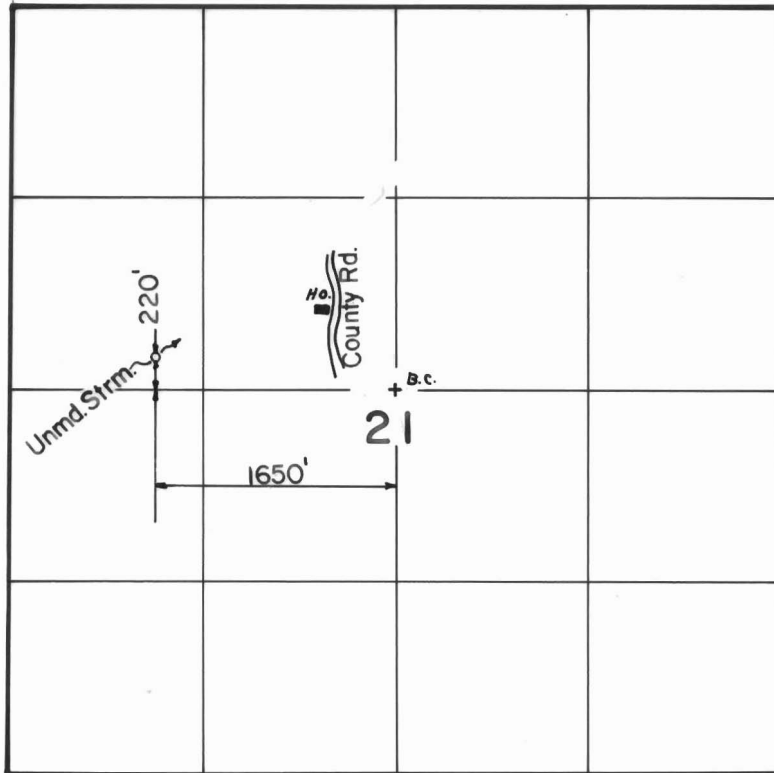

Scale: 1" = 1320'

FINAL PROOF SURVEY
UNDER

Application No. 61084 Permit No. 45498
IN NAME OF

RICHARD L. SAGE

Surveyed JUL. 22. 1988, by B. S. JAMES