


T. 39 S., R. 5 W., W. M.

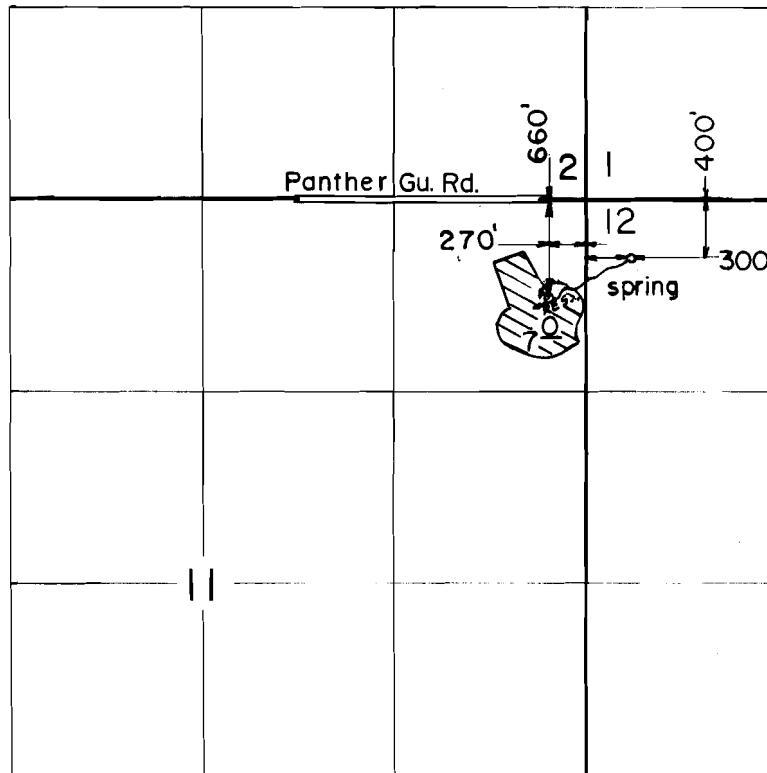

Scale: 1" = 1320'

FINAL PROOF SURVEY
UNDER

R-61411

R-8490

Application No. 61412 Permit No. 46968
IN NAME OF

JOSEPH B. FICHTNER

Surveyed JUL 6 1988, by B...S...JAMES...