


T. 39 S., R. 5 W., W. M.

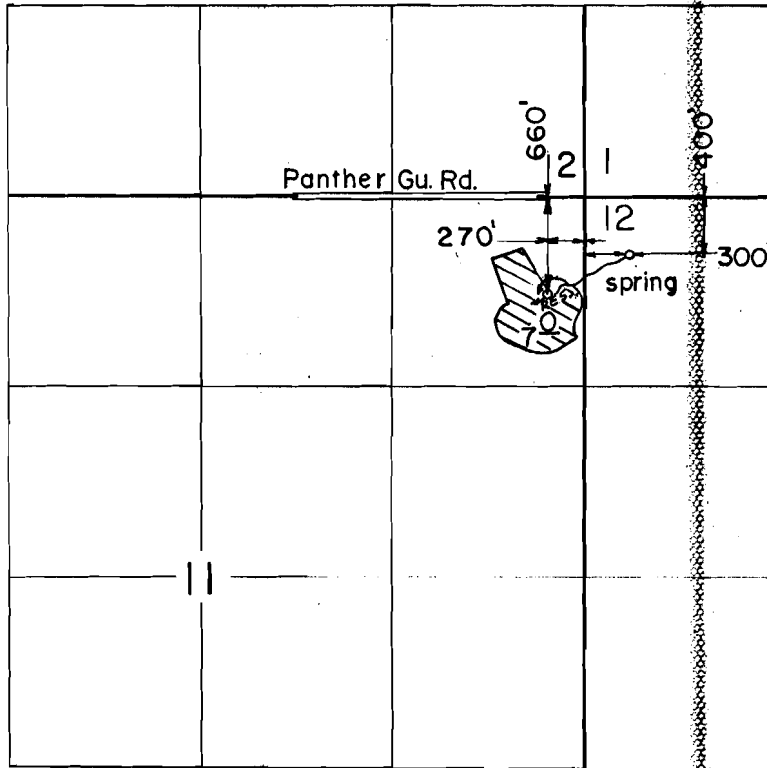

Scale: 1" = 1320'

FINAL PROOF SURVEY
UNDER

R-61411

R-8490

Application No. 61412... Permit No. 46968...

IN NAME OF

.....JOSEPH B. FICHTNER.....

Surveyed JUL...6... 19.8.8, by B...S....JAMES..