
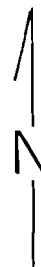


T.18S., R.45E., W.M.

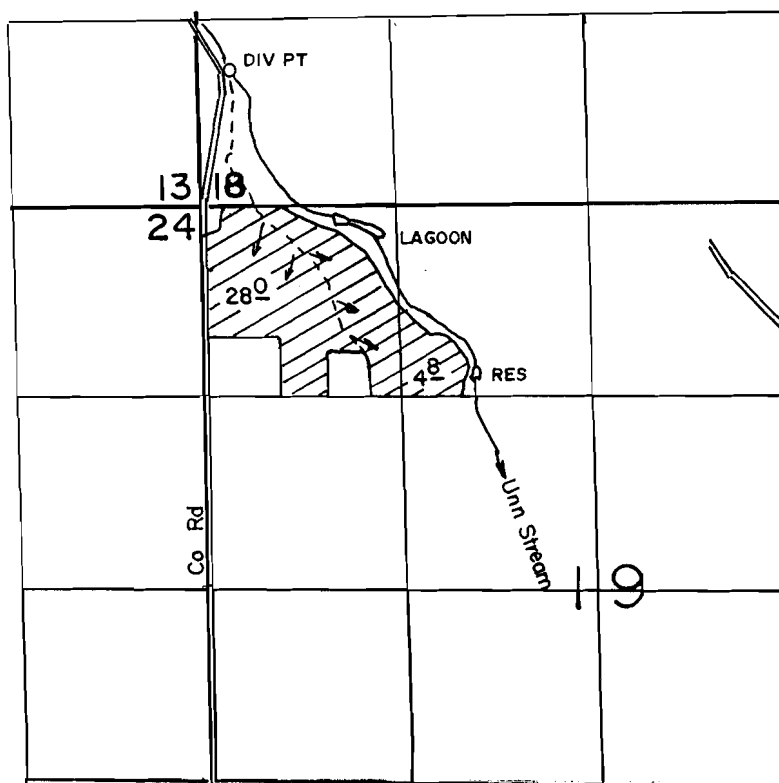

Lagoon Div Loc 90° S & 900' E, Res Div Loc 115° S & 1850' E, Unn Stream Div
Pt Loc 95° N & 250' E, All From NW Corner Of Section 19

SCALE: 1"=1320'

FINAL PROOF SURVEY UNDER

R-61843

R-8364

Application No. 61844..... Permit No. 46462.....

IN NAME OF

...MORGAN & ALICE MITCHELL...

Surveyed OCT. 11... 1988., by V. L. CHURCH.....