


T.18S., R. 45E, W.M.

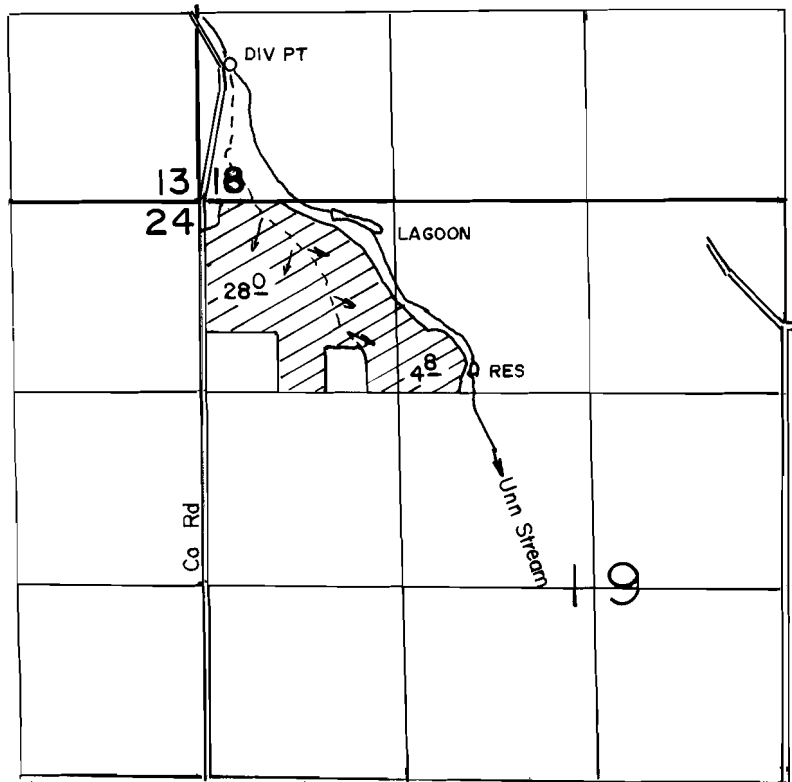

Lagoon Div Loc 90' S & 900' E, Res Div Loc 1150' S & 1850' E, Unn Stream Div
Pt Loc 950' N & 250' E, All From NW Corner Of Section 19

SCALE: 1" = 1320'

FINAL PROOF SURVEY UNDER

R-61843

R-8364

Application No. ~~61844~~..... Permit No. ~~46462~~.....

IN NAME OF

...~~MORGAN & ALICE MITCHELL~~.....

Surveyed ~~OCT. 11~~.... 19~~88~~., by ~~V. L. CHURCH~~.....