90684

T. 28 S., R. 4 W., W.M.

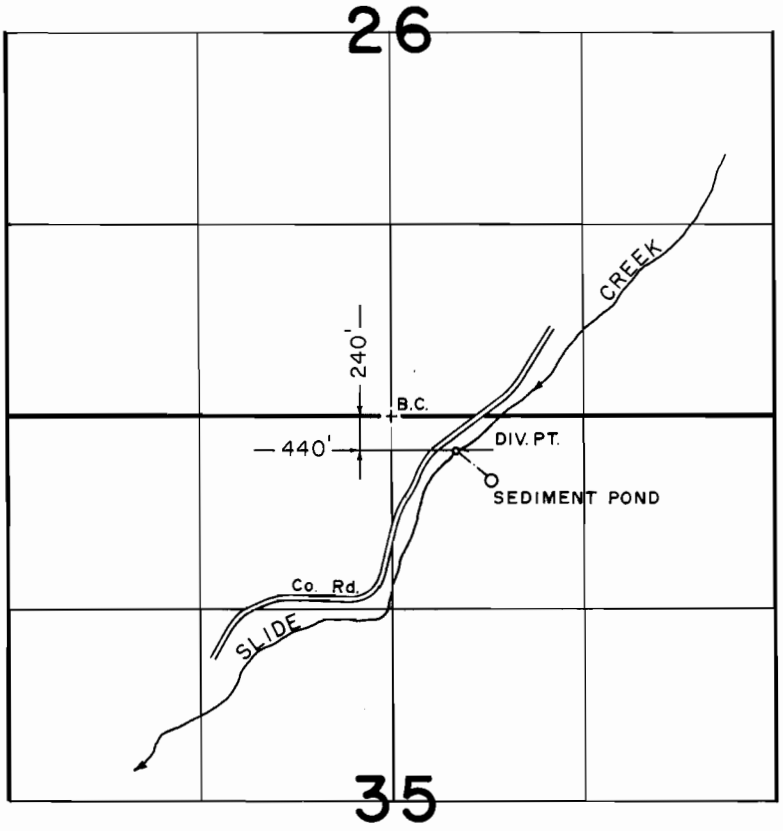

SCALE: 1" = 1320'

FINAL PROOF SURVEY
UNDER

Application No. 63971 Permit No. 47315
IN NAME OF

CHARLES BURNETT

Surveyed MARCH28 1990, by B. S. JAMES

5-18-90
41019-378-223 L