


T. 36 S., R. 4 W., W. M.

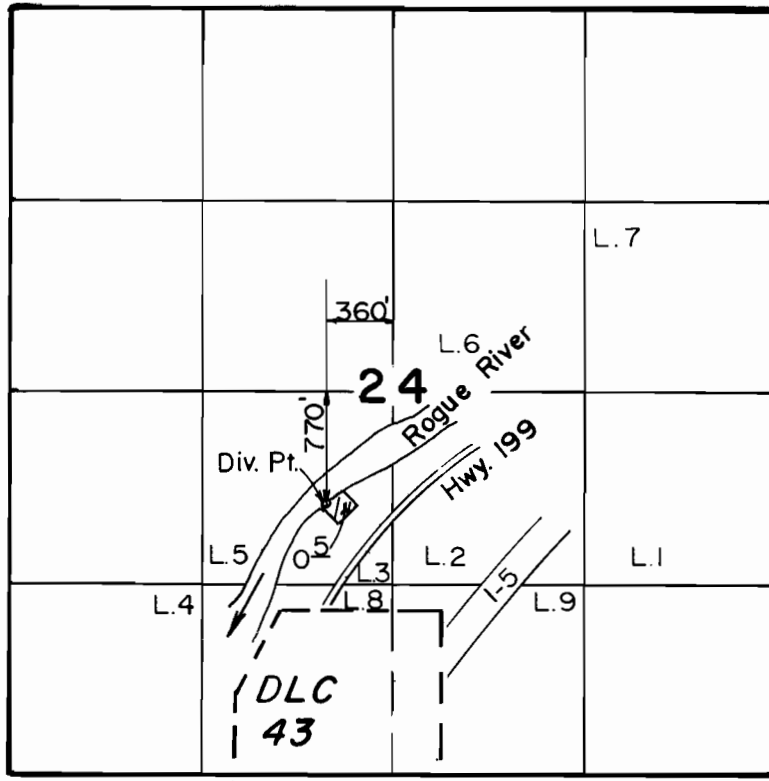

Scale: 1" = 1320'

**FINAL PROOF SURVEY**  
UNDER

Application No. 65287... Permit No. 47912.....  
IN NAME OF

SALVATORE J. DI PAULO

Surveyed FEB. 10 1988, by B. S. JAMES.....