


T. 28 S., R. 4 W., W. M.

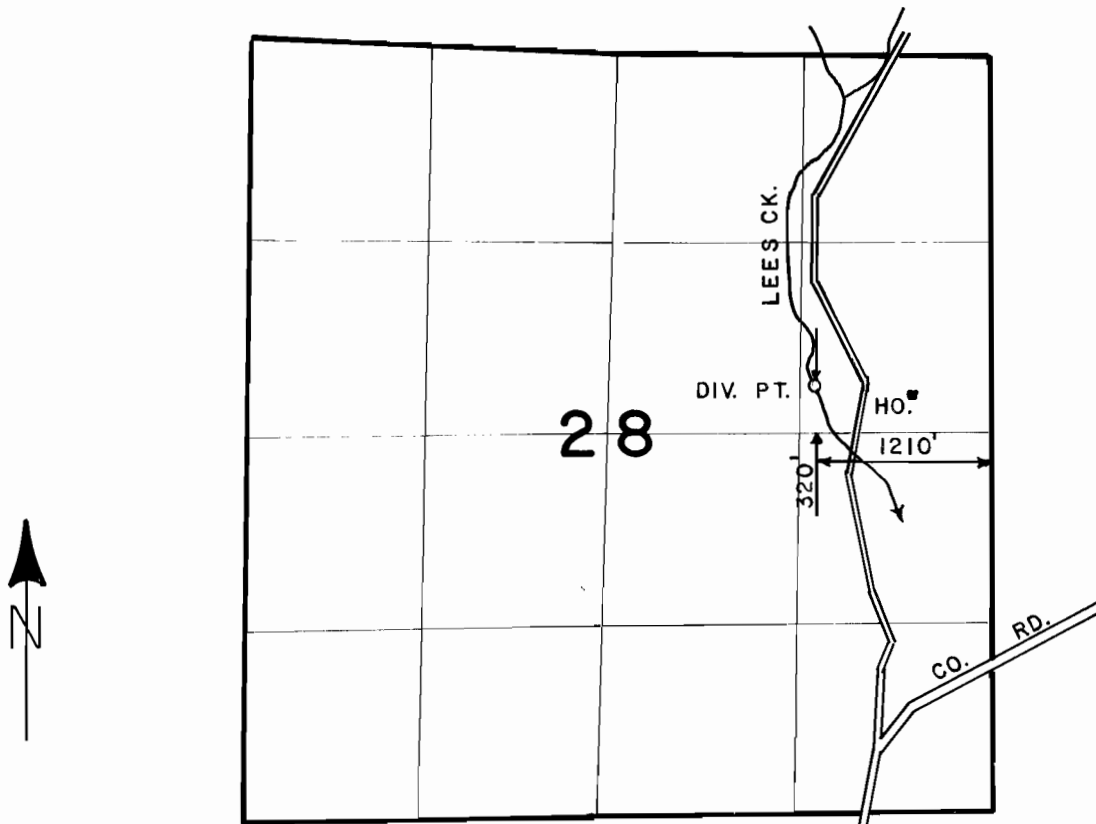

SCALE: 4" = 1 MILE

FINAL PROOF SURVEY
UNDER

Application No. 65493 Permit No. 47975
IN NAME OF

JAMES C. WILBUR

Surveyed AUG. 3, 1988, by J. M. SCHMORDE