


T. 39 S., R. 8 W., W. M.

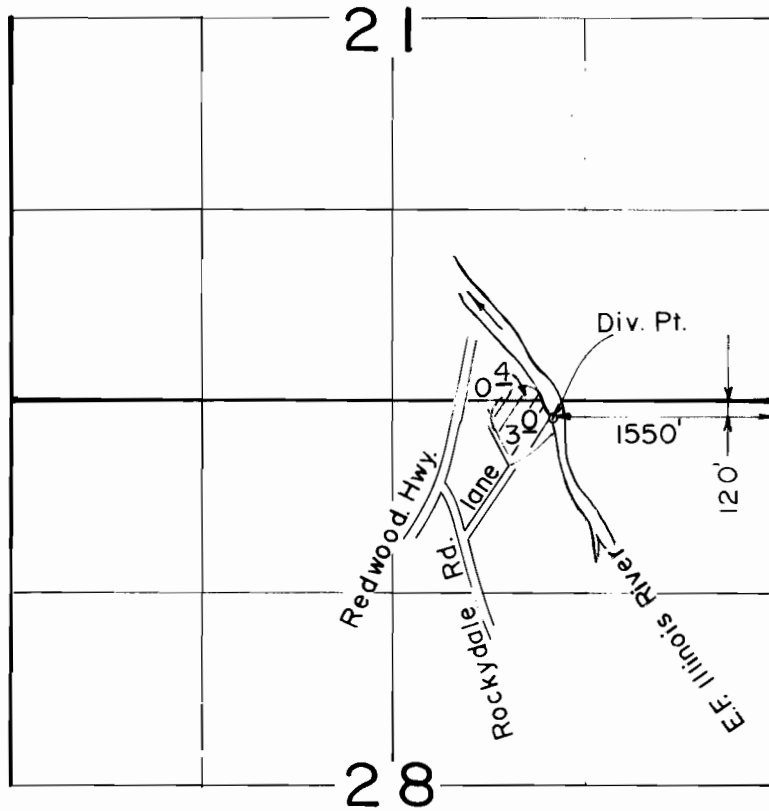

Scale: 1" = 1320'

FINAL PROOF SURVEY
UNDER

Application No. ~~65496~~ Permit No. ~~47770~~
IN NAME OF

GEORGE E. & MARIAN M. CASBIER

Surveyed APR. 14. 1988, by B. S. JAMES...